

Tallahatchie

S 2005

2-15-80

MISSISSIPPI BOARD OF WATER COMMISSIONERS
416 North State Street
Jackson, Mississippi 39201

WATER WELL DRILLERS LOG
BUTANE GAS COMPANY

2-15-80

date well completed

OF GIBLAWOOD

Tallahatchie
county well located

LANDOWNER:

Georgia Smith Estate

Phillipp

(mailing address)

description of formations encountered

from

to

Clay
Sand

0 18
18 40

Sand & Gravel

40 106

WELL LOCATION:

sec. 15 T 22 N R 1 E
S 8 W

2 3/4 miles NE of Phillip
(distance) (direction) (nearest town)

WELL PURPOSE:

Home
(home, irrigation, municipal, industrial)

WELL COMPLETION DATA:

- (1) diameter (inches) 4"
- (2) total depth (feet) 103
- (3) static water level (feet) 80 below top of ground.
- (4) casing PVC, 3", (depth) 4" if telescope see back. (size)
- (5) screen 10, 93 (length) (depth to top)
4" PVC (size) (material)
- (6) pump 1/2, 10 (HP) (yield gpm)
Elec (type power)
- (7) electric log No (yes or no)

(organization running log)

- (8) how well bottom plugged Back Pressure Valve

DRILLERS REMARKS:


DEPT. OF NATURAL RESOURCES
BUREAU OF LAND & WATER RESOURCES

FEB 25 1980

RECEIVED

If well telescopes please sketch and show depths.

GROUND LEVEL

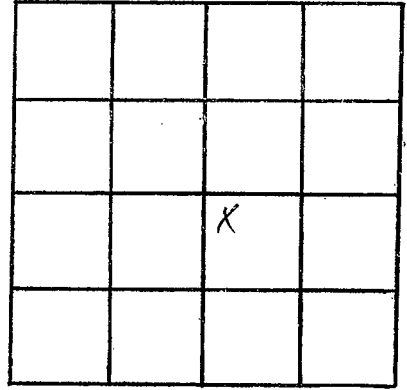

SECTION _____

Please indicate well location X:

ADDITIONAL INFORMATION

If more than one screen,
show locations of each on sketch.