

TALLAHATCHIE

3 zone

2-15-80

MISSISSIPPI BOARD OF WATER COMMISSIONERS
416 North State Street
Jackson, Mississippi 39201

WATER WELL DRILLERS LOG
BUTANE GAS COMPANY
OF GREENWOOD

2-15-80
date well completed

Tallahatchie
county well located

LANDOWNER:

Wesley Stephens

Philipp

(mailing address)

description of formations encountered

from to

Clay

0 18

Sand

18 70

Sand & Gravel

70 96

WELL LOCATION:

sec. 15 T 22 N R 1 E

2 1/2 miles NE of Philipp
(distance) (direction) (nearest town)

WELL PURPOSE:

Home
(home, irrigation, municipal, industrial)

WELL COMPLETION DATA:

- (1) diameter (inches) 4"
- (2) total depth (feet) 86
- (3) static water level (feet) 70 below top of ground.
- (4) casing PVC, 76 (material), (depth)
4" (size) if telescope see back.
- (5) screen 10, 76 (length), (depth to top)
4" (size), PVC (material)
- (6) pump 1/2 (HP), 10 (yield gpm)
Elec (type power)
- (7) electric log No (yes or no)

(organization running log)

(8) how well bottom plugged

DRILLERS REMARKS:


DEPT. OF NATURAL RESOURCES
BUREAU OF LAND & WATER RESOURCES

FEB 25 1980

RECEIVED

If well telescopes please sketch and show depths.

GROUND LEVEL

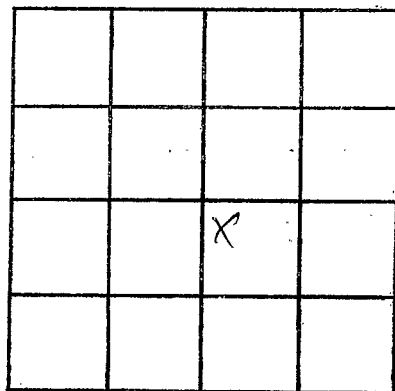

SECTION _____

Please indicate well location X.

ADDITIONAL INFORMATION

If more than one screen,
show locations of each on sketch.