

MISSISSIPPI DEPARTMENT OF ENVIRONMENTAL QUALITY

Office of Land and Water Resources

P. O. Box 10631
Jackson, MS 39289-0631
WATER WELL DRILLERS LOG

COUNTY WELL LOCATED
Tallahatchie

WELL NUMBER **52016** CODED

DATE WELL COMPLETED
8-23-99

PERMIT NUMBER

NAME OF DRILLING FIRM
IRRIGATION EQUIPMENT

601/887-2555

NAME & MAILING ADDRESS OF LANDOWNER
EUTAW Timber
Box 9
Schlater, MS 38952

WELL LOCATION. SEC **26** TOWNSHIP **22** RANGE **1**

DISTANCE **5** Miles DIRECTION **west** NEAREST TOWN **Phillip**

OTHER LANDMARK

WELL PURPOSE: Home, Irrigation, Municipal, Industrial, Fish Pond, etc.

PUMP DATA

PUMP TYPE (Circle One): Submersible, **Turbine**, Jet, Flowing Well, Other (Describe)

POWER TYPE (Circle One): Electric, Tractor, **Diesel**, Gasoline, Butane, Other (Describe) H/P **40**

Pump Capacity (GPM) **2000** No. of Stages **1** Setting Depth **600** FT.

PUMP TEST

Well yielded _____ GPM with a drawdown of _____ ft. after _____ hours of pumping.

WELL DATA

Well Depth 98	Casing Diameter (In.) 16	Casing Length (Ft.) 58
Type of Casing PVC	Hole Depth 98	Depth to Static Water Level 17 ft.

LOG DATA

TYPE OF LOG-RUN (Circle One): No Log Run, Electric, Gamma-Ray, Density, Sonic, Neutron, Other (Describe)

Name of Organization Running Log

TYPE OF COMPLETION: (Circle One or More): **Gravel Packed**, Underreamed, Telescoped, Natural Development, Open Hole, Other (Describe)

GEOLOGIC DATA (Office Use Only)

Surface Elev.	Geologic Unit	Unit Thickness	Depth to Top
Subs. SWL	Date	Analysis	Aquifer Test

WELL GROUTED TO A DEPTH OF _____ FEET
Type Grout (circle one): Cement, Bentonite, or Mix

Driller's Remarks

SCREEN DATA


Diameter - Inches 16	Length - Feet 40	Slot Size - Inches .050
Screen Type PVC	Depth to Bottom - Feet 98	

DESCRIPTION OF FORMATIONS ENCOUNTERED	FROM	TO	FORMATIONS (Continued)	FROM	TO
clay	0	20			
Fine sand	20	31			
Fine sand + Gravel	31	42			
med. sand + Gravel	42	98			

IF MORE SPACE IS NEEDED, USE BACK

If well telescopes please sketch and show depths.

GROUND LEVEL

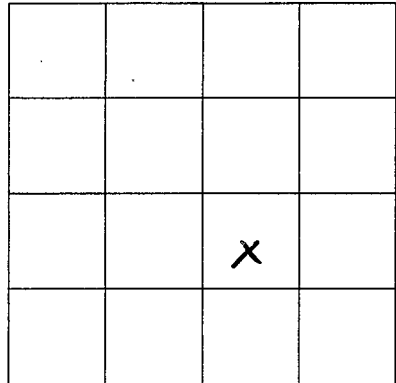

SECTION 26

Please indicate well location X.

ADDITIONAL INFORMATION

A series of horizontal lines for providing additional information.

If more than one screen, show location of each on sketch.