

TALLAHATCHIE

CL-2168 S 20 18

6-10-82

MISSISSIPPI DEPARTMENT OF NATURAL RESOURCES

Bureau of Land and Water Resources

Southport Mall

P.O. Box 10631

Jackson, Mississippi 39209

WATER WELL DRILLERS LOG

6/10

19 82

LAYNE-CENTRAL CO.

TALLAHATCHIE

date well completed

firm name

county well located

LANDOWNER:

Hodges Farms

Philipp, MS

(mailing address)

description of formations encountered

from

to

clay

0

14

c.sand & pea gravel

14

32

c.sand & gravel

32

62

med.coarse sand

62

72

c.sand & pea gravel

72

92

" " " "

92

109

med.coarse sand

109

111

c. sand

111

112

c.sand & gravel

112

117

clay

117

119

#1 WELL LOCATION:

sec. 14 T. 22 N R. 1 E

2 miles E of Philipp (distance) (direction) (nearest town)

WELL PURPOSE: irrigation (home, irrigation, municipal, industrial)

WELL COMPLETION DATA:

- (1) diameter (inches) 32"
(2) total depth (feet) 117'
(3) static water level (feet) 10' below top of ground.
(4) casing steel, 67' (material), (depth) 16" (size) if telescope see back.
(5) screen 50' (length), 67' (depth to top) 16" (size), st. steel (material)
(6) pump 60 (HP), 2500 (yield gpm) electric (type power)
(7) electric log no (yes or no) (organization running log)
(8) how well bottom plugged st. plate

DRILLERS REMARKS:


DEPT. OF NATURAL RESOURCES BUREAU OF LAND & WATER RESOURCES

SEP - 9 1982

RECEIVED

If well telescopes please sketch and show depths.

GROUND LEVEL

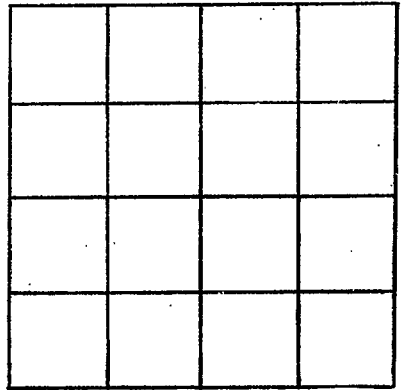

SECTION _____

Please indicate well location X.

ADDITIONAL INFORMATION

If more than one screen, show locations of each on sketch.