

TALLAHATCHIE

CL-2168 S 2019

6-26-82

MISSISSIPPI DEPARTMENT OF NATURAL RESOURCES

Bureau of Land and Water Resources

Southport Mall

P.O. Box 10631

Jackson, Mississippi 39209

WATER WELL DRILLERS LOG

6/26 1982 date well completed

LAYNE-CENTRAL CO. firm name

TALLAHATCHIE county well located

LANDOWNER:

Hodges Farms

Philipp, MS

(mailing address)

description of formations encountered

from

to

clay

0

25

sand & pea gravel

25

40

gravel

40

101

#2 WELL LOCATION:

sec. 24 T 22 N R 1 E
3 miles E of Philipp
(distance) (direction) (nearest town)

WELL PURPOSE: irrigation
(home, irrigation, municipal, industrial)

WELL COMPLETION DATA:

- (1) diameter (inches) 32"
(2) total depth (feet) 101'
(3) static water level (feet) 3' below top of ground.
(4) casing steel 51' (material) (depth) 16" (size) if telescope see back.
(5) screen 50' 51' (length) (depth to top) 16" st. steel (size) (material)
(6) pump 60 2500 (HP) (yield gpm) gear drive (type power)
(7) electric log no (yes or no)
(organization running log)
(8) how well bottom plugged st. plate

DEPT. OF NATURAL RESOURCES
BUREAU OF LAND & WATER RESOURCES


SEP - 9 1982

RECEIVED

DRILLERS REMARKS:

If well telescopes please sketch and show depths.

GROUND LEVEL

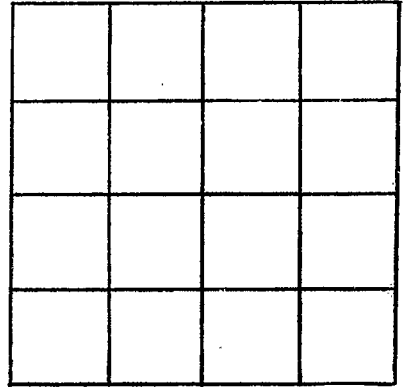

SECTION _____

Please indicate well location X.

ADDITIONAL INFORMATION

If more than one screen, show locations of each on sketch.