

MISSISSIPPI DEPARTMENT OF NATURAL RESOURCES

Bureau of Land and Water Resources

Southport Mall

P.O. Box 10631

Jackson, Mississippi 39209

WATER WELL DRILLERS LOG

*J. L. Hatcher*  
52020  
 CL-2013

8-11 19 81      LAYNE CENTRAL CO.      TALLAHATCHIE  
 date well completed      firm name      county well located

LANDOWNER:	description of formations encountered	from	to
HODGES FARMS			
PHILIPP, MS	fine sand	14	37
(mailing address)	c. sand & gravel	37	42
WELL LOCATION:	" " "	42	52
sec. 13 T 22 N R 1 E	" " "	52	82
4 miles E of Philipp	fine sand	82	85
(distance) (direction) (nearest town)			
WELL PURPOSE:			
(home, irrigation, municipal, industrial)			
WELL COMPLETION DATA:			
(1) diameter (inches) 28"			
(2) total depth (feet) 82'			
(3) static water level (feet) 19' 6" below top of ground.			
(4) casing steel 50' 9" (material), (depth), 16" (size) If telescope see back.			
(5) screen 30' 1" 50' 9" (length), (depth to top), 12" st. steel (size), (material)			
(6) pump 60 1400 (HP), (yield gpm), diesel (type power)			
(7) electric log no (yes or no)			
(organization running log) st. plate			
(8) how well bottom plugged			

DEPT. OF NATURAL RESOURCES  
 BUREAU OF LAND & WATER RESOURCES


JUN 24 1982

RECEIVED

DRILLERS REMARKS:

If well telescopes please sketch and show depths.

GROUND LEVEL

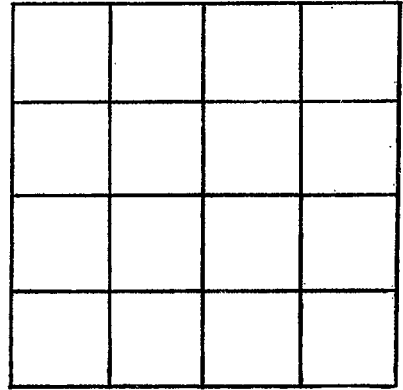

SECTION \_\_\_\_\_

Please indicate well location X.

ADDITIONAL INFORMATION

If more than one screen,  
show locations of each on sketch.