

MISSISSIPPI DEPARTMENT OF NATURAL RESOURCES

Bureau of Land and Water Resources

Southport Mall

P.O. Box 10631

Jackson, Mississippi 39209

WATER WELL DRILLERS LOG

BUTANE GAS CO. OF GREENWOOD

POST OFFICE BOX 1135

GREENWOOD, MISS. 38930 county well located

Dalhatchie
S1021
MS-GW-05459

5-6 1982
date well completed

Dalhatchie

LANDOWNER:	description of fomations encountered	from	to
<u>Ann Reg Corp.</u>			
(mailing address)	<u>Sand & gravel</u>	<u>20</u>	<u>80</u>
WELL LOCATION:	<u>Sand</u>	<u>80</u>	<u>90</u>
sec. <u>20</u> T. <u>22</u> N. R. <u>1 E</u>	<u>Sand & Gravel</u>	<u>90</u>	<u>103</u>
<u>1</u> miles <u>SW</u> of <u>Shiloh</u>			
(distance) (direction) (nearest town)			
WELL PURPOSE: <u>Irrigation</u>			
(home, irrigation, municipal, industrial)			
WELL COMPLETION DATA:			
(1) diameter (inches) <u>16"</u>			
(2) total depth (feet) <u>103</u>			
(3) static water level (feet) <u>15</u> <u>below</u> top of ground.			
(4) casing <u>Steel</u> , <u>63'</u> (material) (depth)			
<u>16"</u> (size) if telescope see back.			
(5) screen <u>40'</u> , <u>63'</u> (length) (depth to top)			
<u>16</u> (size), <u>Steel</u> (material)			
(6) pump <u>60</u> (HP), <u>1200</u> (yield gpm)			
<u>Hand</u> (type power)			
(7) electric log <u>No</u> (yes or no)			
<u>No</u> (organization running log)			
(8) how well bottom plugged <u>Steel plates</u>			

DEPT. OF NATURAL RESOURCES
BUREAU OF LAND & WATER RESOURCES

MAY 10 1982


RECEIVED

DRILLERS REMARKS:

Carlos Simon

If well telescopes please sketch and show depths.

GROUND LEVEL

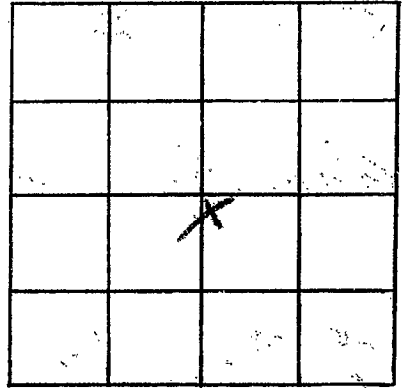

SECTION 20

Please indicate well location X.

ADDITIONAL INFORMATION

Lined area for additional information.

If more than one screen, show locations of each on sketch.