

MISSISSIPPI
BOARD OF WATER COMMISSIONERS
416 North State Street
Jackson, Mississippi 39201

CODED

CODED

WATER WELL DRILLERS LOG

Date
A1
11-23-68

Nov. 23, 1968 Shelby Nymman Date
date well completed firm name county well located

LANDOWNER: Horner Hill
P.O. Box 1
Coldwater Miss
(mailing address)

description of formations encountered	from	to
Red clay	0	58
Red sand & gravel	58	147
Coarse white sand	147	152

WELL LOCATION:
sec. 31 T. 4 N. R. 9 E.
S W
4 miles W. of Arabola
(distance) (direction) (nearest town)

WELL PURPOSE: Home
(home, irrigation, municipal, industrial)

- WELL COMPLETION DATA:
- (1) diameter (inches) 2
 - (2) total depth (feet) 152
 - (3) static water level (feet) 164 below top of ground.
 - (4) casing Galvange 147 (material) (depth)
 - (size) If telescope see back.
 - (5) screen 5 (length) (depth to top)
1 1/2 (size) Stainless Steel (material)
 - (6) pump 1/2 (HP) 4 (yield gpm)
Electric (type power)
 - (7) electric log W (yes or no)
W (organization running log)
 - (8) how well bottom plugged. Rubby Sed

CODED


NEG - 9 1008

MISS. Bd. of WATER COMMISSIONERS

DRILLERS REMARKS:

If well telescopes please sketch and show depths.

GROUND LEVEL

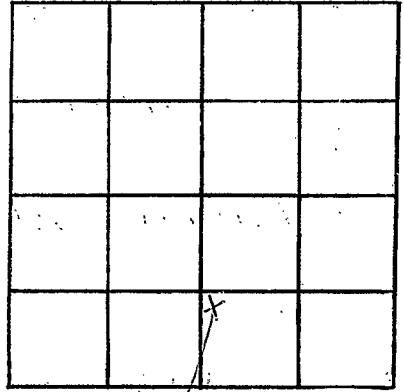

well

SECTION 31

Please indicate well location X.

ADDITIONAL INFORMATION

If more than one screen, show locations of each on sketch.