

TATE  
AZ  
12-30-71

MISSISSIPPI  
BOARD OF WATER COMMISSIONERS  
416 North State Street  
Jackson, Mississippi 39201

**CODED**

WATER WELL DRILLERS LOG

Dec 30 1971 Shelby Myerson Tate  
date well completed firm name county well located

LANDOWNER:	Description of formations encountered	from	to
John French R.F.W. -	Red clay	0	40
Coldwater Miss (mailing address)	Sand & gravel	40	112
WELL LOCATION: sec 30 T # N R 9 W	white clay	112	152
4 miles W of Ospreyville (distance) (direction) (nearest town)	Dark clay	152	315
WELL PURPOSE: Home (home, irrigation, municipal, industrial)	white sand	315	326
WELL COMPLETION DATA:			
(1) diameter (inches) 2			
(2) total depth (feet) 326			
(3) static water level (feet) 130 below top of ground.			
(4) casing Galvanized 321 (material) (depth)			
(size) if telescope see back.			
(5) screen 5 ft (length) (depth to top)			
1/2" Stainless Steel (size) (material)			
(6) pump 1/2 (HP) (yield gpm)			
Electric (type power)			
(7) electric log no (yes or no)			
(organization running log)			
(8) how well bottom plugged Rubber Seal			
DRILLERS REMARKS:			


**CODED**

JAN 18 1972

MISS EN 05  
MAYED ROOM  
DELETED

If well telescopes please sketch and show depths.

GROUND LEVEL

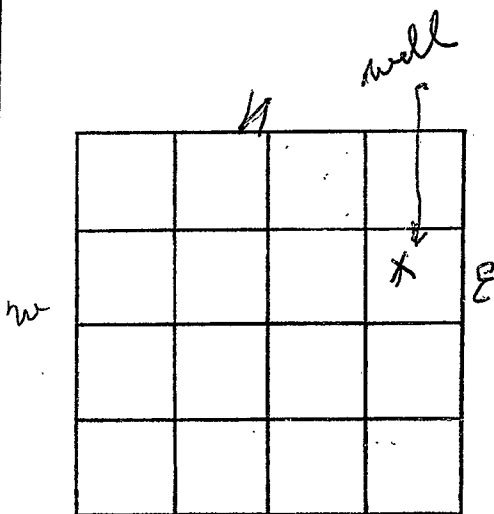

SECTION 30

Please indicate well location X.

ADDITIONAL INFORMATION

If more than one screen, show locations of each on sketch.