

Date
A3
4-20-69

MISSISSIPPI
 BOARD OF WATER COMMISSIONERS
 416 North State Street
 Jackson, Mississippi 39201

WATER WELL DRILLERS LOG

April 20 1969, Shelby Newman 701
 date well completed firm name county well located

LANDOWNER: Newton Newman
Port, MS
Coldwater MS 42
 (mailing address)

description of formations encountered	from	to
<u>Red clay</u>	<u>0</u>	<u>30</u>
<u>Red Sand & gravel</u>	<u>30</u>	<u>80</u>
<u>grey clay</u>	<u>80</u>	<u>220</u>
<u>Grey Sand</u>	<u>220</u>	<u>238</u>

WELL LOCATION:
 sec. 16 T. 4 N. R. 9 E.
S W
4 miles NW of Oshtobata
 (distance) (direction) (nearest town)

WELL PURPOSE: Home
 (home, irrigation, municipal, industrial)

- WELL COMPLETION DATA:
- (1) diameter (inches) 2
 - (2) total depth (feet) 238
 - (3) static water level (feet) 90 below above top of ground.
 - (4) casing Galvange, 231
 (material) (depth)
 (size) if telescope see back.
 - (5) screen 6 ft, 232
 (length) (depth to top)
1 1/2, Galvange
 (size) (material)
 - (6) pump 1, 6
 (HP) (yield gpm)
Electric
 (type power)
 - (7) electric log no
 (yes or no)
no
 (organization running log)
 - (8) how well bottom plugged Rubber Seal


MAY 26 1969

DRILLERS REMARKS:

MADE BY US
 INSTEAD OF
 USING THE
 CONING

If well telescopes please sketch and show depths.

GROUND LEVEL

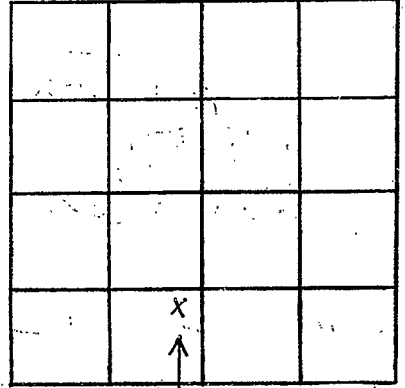

WELL SECTION 16

Please indicate well location X.

ADDITIONAL INFORMATION

If more than one screen, show locations of each on sketch.