

CODED

MISSISSIPPI
BOARD OF WATER COMMISSIONERS
416 North State Street
Jackson, Mississippi 39201

WATER WELL DRILLERS LOG

Late
AG
11-25-69

Nov 25 1969 Shelby Neyman
date well completed firm name

Late
county well located

LANDOWNER: Rahole Burton

description of formations encountered

from to

R. T. D. - - 1

Red clay

0 40

Coldwater Miss
(mailing address)

Red sandstone gravel

40 100

WELL LOCATION:

sec. 16 T. 4 N. R. 9 E. S. 5
3 miles N of Carabatta
(distance) (direction) (nearest town)

Blue Clay

100 190

WELL PURPOSE: Home
(home, irrigation, municipal, industrial)

Grey Sand

190 216

WELL COMPLETION DATA:

- (1) diameter (inches) 2
- (2) total depth (feet) 216
- (3) static water level (feet) 80 below top of ground.
- (4) casing Galvanize 2 1/2 ft
(material) (depth)
- (size) if telescope see back.
- (5) screen 5 ft
(length) (depth to top)
- 1 1/4 in Stainless Steel
(size) (material)
- (6) pump 1/2 H
(HP) (yield gpm)
- Electric
(type power)
- (7) electric log no
(yes or no)
- (organization running log)
- (8) how well bottom plugged Rubber Seal


DRILLERS REMARKS:

MISS. BD. OF
WATER COM.

0 10 1969

If well telescopes please sketch and show depths.

GROUND LEVEL

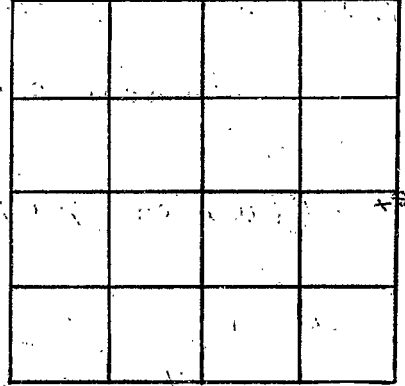

SECTION 16

Please indicate well location X.

ADDITIONAL INFORMATION

If more than one screen, show locations of each on sketch.