

CODED

Tate Co
A 8
11-69

MISSISSIPPI
BOARD OF WATER COMMISSIONERS
416 North State Street
Jackson, Mississippi 39201
WATER WELL DRILLERS LOG


11-29-1969 Bob Smith Tate
date well completed firm name county well located

LANDOWNER:	description of formations encountered	from	to
Stinson Coldwater, Miss. (mailing address)			
WELL LOCATION: sec. 16 T 4 N R 9 E 3 miles N of Inkster (distance) (direction) (nearest town)			
WELL PURPOSE: (home, irrigation, municipal, industrial)			
WELL COMPLETION DATA:			
(1) diameter (inches) 4			
(2) total depth (feet) 85			
(3) static water level (feet) 60 below top of ground.			
(4) casing 4" plate, 85' (material) (depth)			
(size) if telescope see back.			
(5) screen 20' 65' (length) (depth to top)			
4" plate (size) (material)			
(6) pump 7/4 (HP) 15 (yield gpm)			
8 hp (type power)			
(7) electric log no (yes or no)			
(organization running log)			
(8) how well bottom plugged plugged			
DRILLERS REMARKS: Bad gravel			

NOV 30 1969
MISS. Bd. OF WATER COMMISSIONERS

If well telescopes please sketch and show depths.

GROUND LEVEL

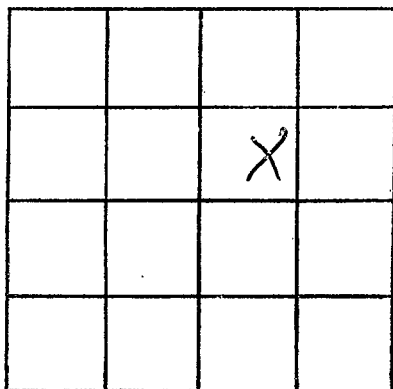

SECTION _____

Please indicate well location X.

ADDITIONAL INFORMATION

If more than one screen, show locations of each on sketch.