

MISSISSIPPI
BOARD OF WATER COMMISSIONERS
416 North State Street
Jackson, Mississippi 39201

WATER WELL DRILLERS LOG

Tate Co
A 11
4-24-70

April 24 1970 Shelby Neyman Tate
date well completed firm name county well located

LANDOWNER: I. M. McClure description of formations encountered from to
Trustee for H. P. Mc Gaha Black clay 0 20
Senatobia Miss grey clay 20 155
(mailing address)

WELL LOCATION: 140
sec. 21 T. 4 N R. 9 E
4 miles NW of Arhobutta
(distance) (direction) (nearest town)

WELL PURPOSE: Home
(home, irrigation, municipal, industrial)

- WELL COMPLETION DATA:
- (1) diameter (inches) 2
 - (2) total depth (feet) 177
 - (3) static water level (feet) 18 below above top of ground.
 - (4) casing Galv. (material) (depth)
____ if telescope see back.
(size)
 - (5) screen 5ft (length) (depth to top)
1/4" Stlt (size) (material)
 - (6) pump 1 (HP) 19 (yield gpm)
Electric (type power)
 - (7) electric log No (yes or no)
No (organization running log)
 - (8) how well bottom plugged Rubber Seal

MAY 15 1970


MISS. BD. OF
WATER COMM.

DRILLERS REMARKS:

If well telescopes please sketch and show depths.

GROUND LEVEL

well

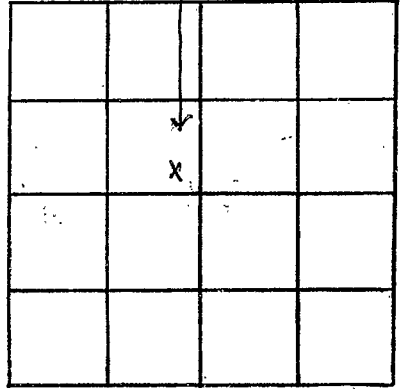

SECTION 21

Please indicate well location X.

ADDITIONAL INFORMATION

If more than one screen, show locations of each on sketch.