

**Tate Co**  
**A 12**

MISSISSIPPI  
 BOARD OF WATER COMMISSIONERS  
 416 North State Street  
 Jackson, Mississippi 39201

WATER WELL DRILLERS LOG

date well completed 19 70 Shelby Keyman firm name Tate county well located

LANDOWNER: W. E. McPherson

description of formations encountered	from	to
<u>Black clay</u>	<u>0</u>	<u>10</u>
<u>Blue clay</u>	<u>10</u>	<u>60</u>
<u>Grey Sand</u>	<u>60</u>	<u>65</u>
<u>Clear white sand</u>	<u>65</u>	<u>73</u>

Richard Miss  
 (mailing address)

WELL LOCATION: 140  
 sec 25 T H R. 1D  
1 miles E of Richard  
 (distance) (direction) (nearest town)

WELL PURPOSE: Home  
 (home, irrigation, municipal, industrial)

WELL COMPLETION DATA:


- (1) diameter (inches) 2
- (2) total depth (feet) 73
- (3) static water level (feet) 16 below above top of ground.
- (4) casing Galv. (material) (depth)  
 (size) if telescope see back.
- (5) screen 5 ft (length) (depth to top)  
1/4" St. St. (size) (material)
- (6) pump 1/2 (HP) 12 (yield gpm)  
Electric (type power)
- (7) electric log No (yes or no)  
No (organization running log)
- (8) how well bottom plugged Rubber seal

DRILLERS REMARKS:

MAY 15 1970  
 MISS. BD. OF  
 WATER COM.

If well telescopes please sketch and show depths.

GROUND LEVEL

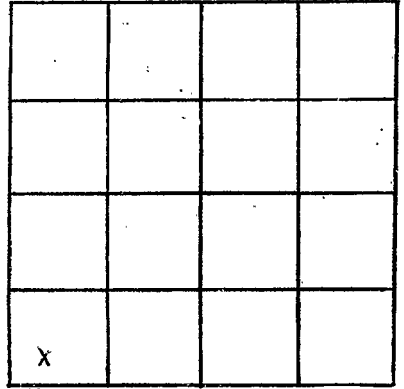

SECTION 25

Please indicate well location X.

ADDITIONAL INFORMATION

If more than one screen, show locations of each on sketch.