

TATE
A13
9-5-70

MISSISSIPPI
BOARD OF WATER COMMISSIONERS
416 North State Street
Jackson, Mississippi 39201

CODED

WATER WELL DRILLERS LOG

Sept 5 1970 Shelly Keyman Tate
date well completed firm name county well located

| LANDOWNER: | Description of formations encountered | from | to |
|---|---------------------------------------|------|----|
| J. E. Smith R. F. D. - 1 Coldwater, Miss. (mailing address) | Block clay | 0 | 10 |
| WELL LOCATION: sec. 30 T. 4 N. S. R. 9 E. W. # miles W of Arabon (distance) (direction) (nearest town) | Grey sandy clay | 10 | 60 |
| WELL PURPOSE: Farm (home, irrigation, municipal, industrial) | the white sand | 1.6 | 90 |
| WELL COMPLETION DATA: (1) diameter (inches) 2 | | | |
| (2) total depth (feet) 70 | | | |
| (3) static water level (feet) 16 below top of ground. | | | |
| (4) casing Galvanneal 84 (material) (depth) | | | |
| 1 1/2 (size) if telescope see back. | | | |
| (5) screen 5 (length) (depth to top) | | | |
| 1 1/4 (size) Copper Slat (material) | | | |
| (6) pump Free Pumping (HP) (yield gpm) | | | |
| stand (type power) | | | |
| (7) electric log No (yes or no) | | | |
| Mo (organization running log) | | | |
| (8) how well bottom plugged Rubber Seal | | | |
| DRILLERS REMARKS: | | | |


CODED

OCT 14 1970

MISS. BD. OF
WATER COM.

If well telescopes please sketch and show depths.

GROUND LEVEL

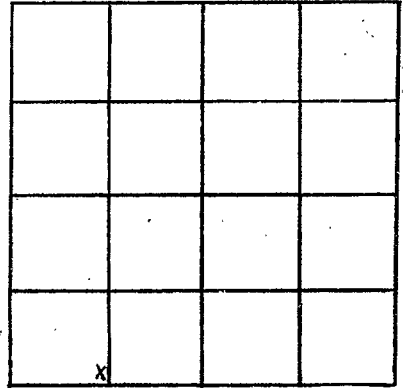

WELL

SECTION 30

Please indicate well location X.

ADDITIONAL INFORMATION

If more than one screen,
show locations of each on sketch.