

TATE
A 15
9-14-70

MISSISSIPPI
BOARD OF WATER COMMISSIONERS
416 North State Street
Jackson, Mississippi 39201

CODED

WATER WELL DRILLERS LOG

Sept 14 1970 Shelby Newman Tate
date well completed firm name county well located

LANDOWNER: <u>Stan Daniels</u>	description of formations encountered	from	to
<u>R.F.D. - 1</u>	<u>Red clay</u>	<u>0</u>	<u>20</u>
<u>Coldwater Miss</u> (mailing address)	<u>Red Sandstone band</u>	<u>20</u>	<u>40</u>
WELL LOCATION: sec. <u>24</u> T. <u>4</u> N R. <u>9</u> E <u>2 1/2</u> miles <u>N</u> of <u>Arbuckle</u> (distance) (direction) (nearest town)	<u>White clay</u>	<u>40</u>	<u>60</u>
WELL PURPOSE: <u>for water</u> (home, irrigation, municipal, industrial)	<u>White sand</u>	<u>60</u>	<u>77</u>

- WELL COMPLETION DATA:
- (1) diameter (inches) 2
 - (2) total depth (feet) 77
 - (3) static water level (feet) 60 below above top of ground.
 - (4) casing Galvneq 70
(material) (depth)
(size) if telescope see back.
 - (5) screen 5ft
(length) (depth to top)
1/4" Stainless Steel
(size) (material)
 - (6) pump 1
(HP) (yield gpm)
Electric
(type power)
 - (7) electric log No
(yes or no)
No
(organization running log)
 - (8) how well bottom plugged crushed rock

CODED

OCT 14 1970


MISS. RD. CO.
MISS.
WATER COM.
JACKSON, MISS.

DRILLERS REMARKS:

If well telescopes please sketch and show depths.

GROUND LEVEL

Well

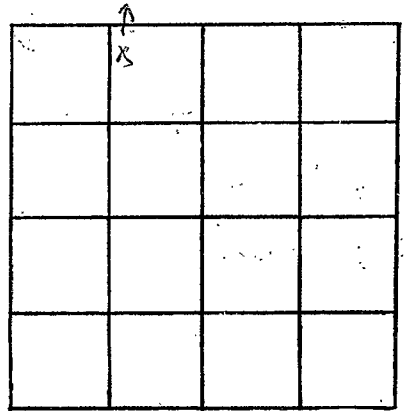

SECTION 24

Please indicate well location X.

ADDITIONAL INFORMATION

If more than one screen,
show locations of each on sketch.