

TATE  
A16  
9-20-70

MISSISSIPPI  
BOARD OF WATER COMMISSIONERS  
416 North State Street  
Jackson, Mississippi 39201

**CODED**

WATER WELL DRILLERS LOG

9-20 1970 Harris Bros. Tate  
date well completed firm name county well located

LANDOWNER: Leon Clark  
Pt. 1  
Coldwater  
(mailing address)  
WELL LOCATION:  
sec. 27 T. 4 N. R. 9 E.  
2 miles N of Arkabutla  
(distance) (direction) (nearest town)

description of formations encountered	from	to
top soil	0	20
fine sand & clay	20	140
fine sand	140	190
coarse sand	190	220

WELL PURPOSE: none  
(home, irrigation, municipal, industrial)

WELL COMPLETION DATA:  
(1) diameter (inches) 4  
(2) total depth (feet) 220  
(3) static water level (feet) 80 <sup>below</sup> top of ground.  
(4) casing Plastic, 206 (material) (depth)  
4 (size) if telescope see back.  
(5) screen 14' 206' (length) (depth to top)  
#008 Plastic (size) (material)  
(6) pump 3/4 7 (HP) (yield gpm)  
Elec. (type power)  
(7) electric log no (yes or no)  
(organization running log)  
(8) how well bottom plugged muck  
shot

**CODED**


NOV 12 1970

MISS. BD. OF  
WATER COMMISSIONERS

DRILLERS REMARKS:

If well telescopes please sketch and show depths.

GROUND LEVEL

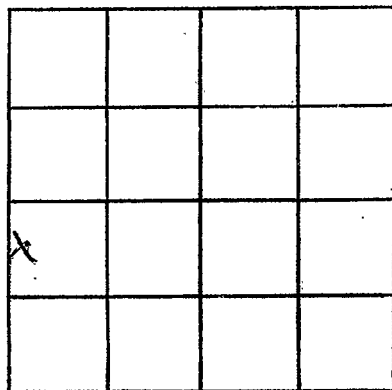

SECTION 27

Please indicate well location X.

ADDITIONAL INFORMATION

If more than one screen,  
show locations of each on sketch.