

TATE
A 17
11-12-70

MISSISSIPPI
BOARD OF WATER COMMISSIONERS
416 North State Street
Jackson, Mississippi 39201

CODED

WATER WELL DRILLERS LOG

November 12 19 70 Jim Ruffin Tate
date well completed firm name county well located

LANDOWNER:
Dallas Brannon
R-1 Caldwell, Miss
(mailing address)

description of formations encountered	from	to
Clay	0	50
Sand & Gravel	50	70
Sand	70	86

WELL LOCATION:
sec. 33 T. 4 S. R. 9 W.
13 miles W of Caldwell
(distance) (direction) (nearest town)

WELL PURPOSE: Home
(home, irrigation, municipal, industrial)


- WELL COMPLETION DATA:
- (1) diameter (inches) 2 in + 1/4 in
 - (2) total depth (feet) 86
 - (3) static water level (feet) 75 below top of ground.
 - (4) casing 2 + 1 1/2 + 86 ft
(material) (depth)
 - (size) If telescope see back.
 - (5) screen 4 ft, 82 ft
(length) (depth to top)
 - 1 1/4, brass
(size) (material)
 - (6) pump 3/4, 3
(HP) (yield gpm)
 - Elec.
(type power)
 - (7) electric log no
(yes or no)
 - (organization running log)
 - (8) how well bottom plugged open

CODED

DEC 9 1970
MISS. BD. OF WATER COMM.

DRILLERS REMARKS:

If well telescopes please sketch and show depths.

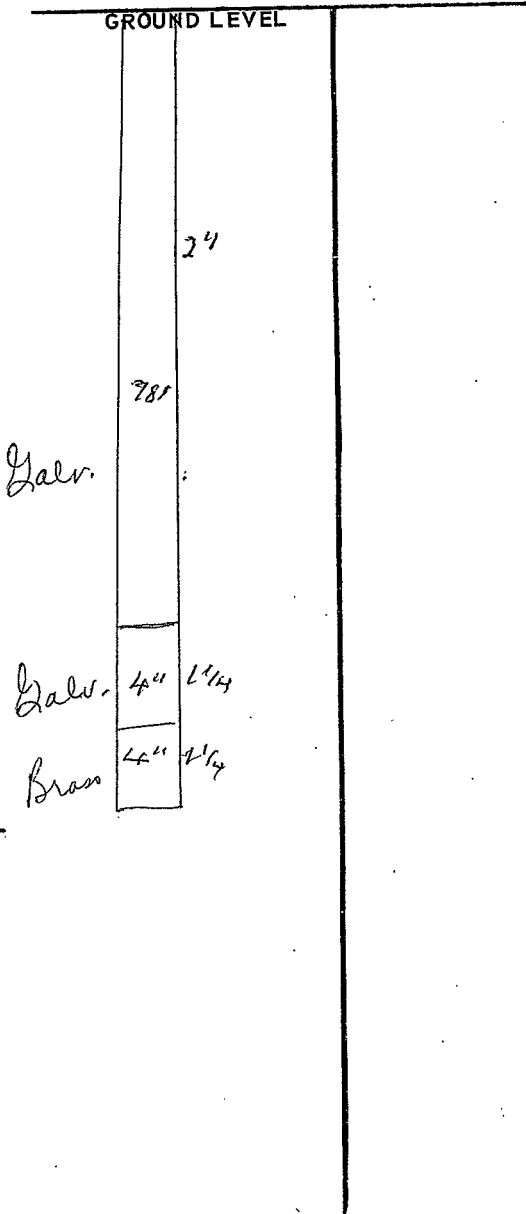

			X

SECTION 33

Please indicate well location X.

ADDITIONAL INFORMATION

If more than one screen,
show locations of each on sketch.