

MISSISSIPPI  
BOARD OF WATER COMMISSIONERS  
416 North State Street  
Jackson, Mississippi 39201

**CODED**

WATER WELL DRILLERS LOG

TATE  
A1B  
3-28-71

March 28 1971, Shelby R. Neyman Late  
date well completed firm name county well located

LANDOWNER: A. R. Bush  
R. F. D. - 1  
Coldwater Miss  
(mailing address)

description of formations encountered	from	to
<u>Red clay</u>	<u>0</u>	<u>40</u>
<u>grey clay</u>	<u>46</u>	<u>120</u>
<u>mixure of white clay &amp; sand</u>	<u>120</u>	<u>190</u>
<u>clear sand</u>	<u>190</u>	<u>220</u>

WELL LOCATION:  
sec. 24 T. 4 N. R. 9 E.  
3 miles NE of Ark  
(distance) (direction) (nearest town)

WELL PURPOSE: swine farm  
(home, irrigation, municipal, industrial)

- WELL COMPLETION DATA:
- (1) diameter (inches) 4
  - (2) total depth (feet) 220
  - (3) static water level (feet) 61 below top of ground.
  - (4) casing Plastic, 220,  
(material) (depth)  
(size) if telescope see back.
  - (5) screen 20ft,  
(length) (depth to top)  
4, Plastic  
(size) (material)
  - (6) pump 2 43  
(HP) (yield gpm)  
Electric  
(type power)
  - (7) electric log no  
(yes or no)  
no  
(organization running log)
  - (8) how well bottom plugged Plastic cap

**CODED**

APR 12 1971


MISS. Bd. OF  
WATER COMM.

DRILLERS REMARKS:

If well telescopes please sketch and show depths.

GROUND LEVEL

Well

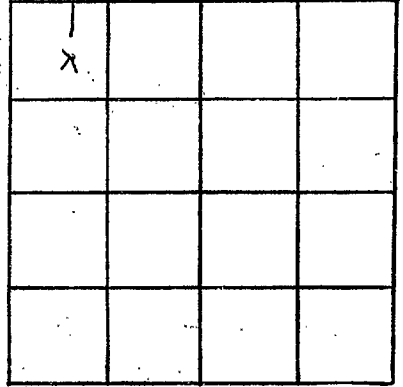

SECTION 24

Please indicate well location X.

ADDITIONAL INFORMATION

If more than one screen, show locations of each on sketch.