

TATE
AZI
2-15-71

MISSISSIPPI
BOARD OF WATER COMMISSIONERS
416 North State Street
Jackson, Mississippi 39201

CODED

WATER WELL DRILLERS LOG

2-15 1971 Harris Bros. Tate
date well completed firm name county well located

| LANDOWNER: Royce Perryman pt. 1 Coldwater (mailing address) | description of formations encountered | from | to |
|--|---------------------------------------|------|-----|
| | top soil | 0 | 15 |
| | sand + gravel | 15 | 50 |
| | clay + sand | 50 | 125 |
| | coarse sand | 125 | 150 |
| WELL LOCATION: sec. 32 T 4 N R 9 E 3 miles W of Arkabutla (distance) (direction) (nearest town) | | | |
| WELL PURPOSE: home (home, irrigation, municipal, industrial) | | | |
| WELL COMPLETION DATA: (1) diameter (inches) 4 (2) total depth (feet) 150 (3) static water level (feet) 80 ^{below} above top of ground. (4) casing <u>Plastic</u> , 136' (material) (depth) 4 (size) if telescope see back. (5) screen 14' (length), 136' (depth to top) <u>oek, Plastic</u> (size) (material) (6) pump 3/4 (HP), 7 (yield gpm) <u>elec.</u> (type power) (7) electric log <u>no</u> (yes or no) (organization running log) (8) how well bottom plugged <u>back</u> <u>spot</u> | | | |
| DRILLERS REMARKS: | | | |


CODED

MAY 14 1971

MISS. BD. OF
WATER COM.

If well telescopes please sketch and show depths.

GROUND LEVEL

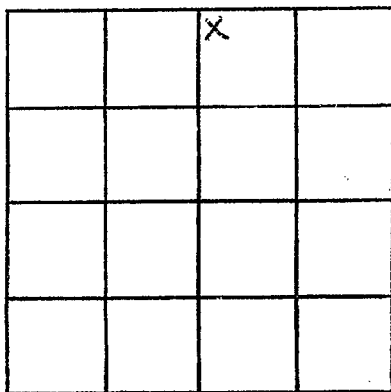

SECTION 32

Please indicate well location X.

ADDITIONAL INFORMATION

If more than one screen, show locations of each on sketch.