

TATE

MISSISSIPPI

A 23

4-30-62

WATER WELL LOG

CODED

Date: April 30, 1962, Driller: Shelly Neyman County

FURNISS (Name)

(1) Owner of Land: Sidney E. Furniss (Name)

Coldwater Miss R-1 (Address)

(2) Location: 1/4, 1/4, Sec. 28 49 T. R.

3 miles (distance), (N) (direction), of Arabhatta (Nearest Town)

(3) Topography: (Hilly) (Flat) (Level)

(4) Purpose of Well: Home use (Domestic Irrigation, Municipal, Industrial, Other)

Description & Color of Materials Sand, Clay, Red Clay, Shell, etc.	Thick- ness Feet	Depth Feet
Red clay	46	46
Red sand	10	10
Gravel l. sand	25	25
water sand	15	15
Total		90

Information upon completion of well:

(1) Diameter 2 inches.

(2) Total Depth 90 feet.

(3) Water Level 68 feet below top of ground.

(4) Cased to _____, Size _____

(5) Screen: Size 96, Length 6 ft

(6) Were any formations sealed against pollution?


yes, no. (checked)

If YES depth of formation _____

Why _____

Drillers Remarks: _____

CODED

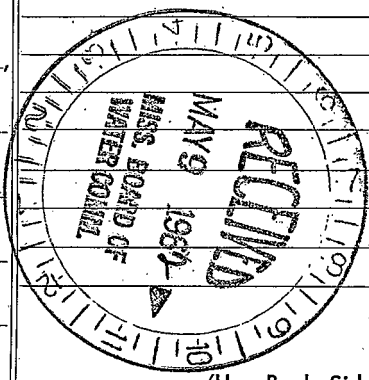

(Use Back Side)

Well No.

