

TATE  
A 25  
8-15-72

MISSISSIPPI  
BOARD OF WATER COMMISSIONERS  
416 North State Street  
Jackson, Mississippi 39201

CODED

WATER WELL DRILLERS LOG

8-15 1972 Harris Bros. Late  
date well completed firm name county well located

LANDOWNER: Frank Payson  
Pt. 1 Box 95  
Coldwater  
(mailing address)

description of formations encountered	from	to
top soil	0	20
white clay	20	45
clay & sand	45	115
Coarse sand	115	130

WELL LOCATION:  
sec. 25 T. 4 N. R. 9 E  
2 miles NE of Arabutta  
(distance) (direction) (nearest town)

WELL PURPOSE: home  
(home, irrigation, municipal, industrial)

WELL COMPLETION DATA:

(1) diameter (inches) 4

(2) total depth (feet) 130

(3) static water level (feet) 60 <sup>below</sup> top of ground.

(4) casing Plastic, 123 (material) (depth)  
4 (size) if telescope see back.

(5) screen 7, 123 (length) (depth to top)  
008 Plastic (size) (material)

(6) pump 3/4, 10 (HP) (yield gpm)  
elec. (type power)

(7) electric log no (yes or no)

(organization running log)

(8) how well bottom plugged solid

CODED


NOV - 1 1972

DRILLERS REMARKS:

MISS. BD. OF  
WATER COMMISSIONERS

If well telescopes please sketch and show depths.

GROUND LEVEL

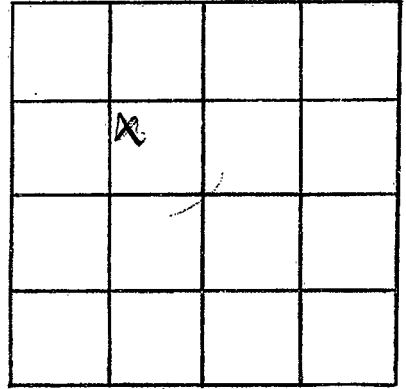

SECTION 25

Please indicate well location X.

ADDITIONAL INFORMATION

If more than one screen,  
show locations of each on sketch.