

MISSISSIPPI
BOARD OF WATER COMMISSIONERS
416 North State Street
Jackson, Mississippi 39201

CODED

WATER WELL DRILLERS LOG

TATE
A 26
3-6-73

3-6-19 73 Bob Smith Jate
date well completed firm name county well located

LANDOWNER:

John Henry Choby
Arkaboth - Miss.
(mailing address)

description of formations encountered

from to
25

clay dirt

Red clay 25 42

red sand 42 60

gravel 60 95

Gumbo at 95

WELL LOCATION:

sec. 22 T 4 N R. 9 E
2 1/2 miles NW of Arkaboth
(distance) (direction) (nearest town)

WELL PURPOSE: None
(home, irrigation, municipal, industrial)

WELL COMPLETION DATA:

- (1) diameter (inches) 4
(2) total depth (feet) 95
(3) static water level (feet) 70 below above top of ground.

- (4) casing Plastic 95
(material) (depth)
(size) if telescope see back.

- (5) screen 20 75
(length) (depth to top)
4 Plastic
(size) (material)

- (6) pump 1/2 10
(HP) (yield gpm)
Elec.
(type power)

- (7) electric log no
(yes or no)

(organization running log)

- (8) how well bottom plugged plugged

CODED


DRILLERS REMARKS:

APR 10 1973

DATE OF LOG
WELL NO.

If well telescopes please sketch and show depths.

GROUND LEVEL

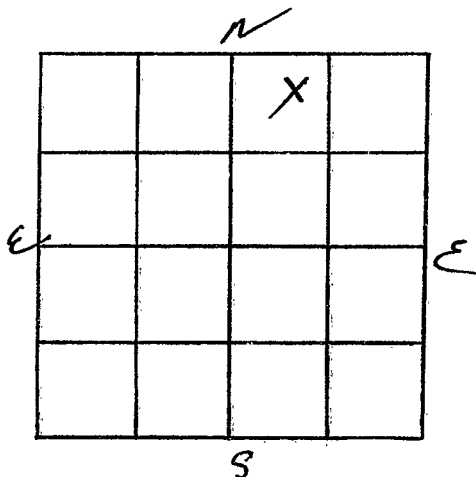

SECTION 22

Please indicate well location X.

ADDITIONAL INFORMATION

If more than one screen, show locations of each on sketch.