

MISSISSIPPI
BOARD OF WATER COMMISSIONERS
416 North State Street
Jackson, Mississippi 39201

CODED

WATER WELL DRILLERS LOG

TATE
A 27
3-6-73

3-6-1973 date well completed Bob Smith firm name Tate county well located

LANDOWNER:

Walter Tolbert
Auburndale - Miss
(mailing address)

description of formations encountered

description of formations encountered	from	to
clay dirt		20
Red clay	20	40
white clay	40	60
gravel	60	90
Gumbo at		90

WELL LOCATION:

sec. 28 T 4 N R 9 E
2 miles West of Auburndale
(distance) (direction) (nearest town)

WELL PURPOSE: Home
(home, irrigation, municipal, industrial)

WELL COMPLETION DATA:

- (1) diameter (inches) 4
- (2) total depth (feet) 90
- (3) static water level (feet) 60 below top of ground.
- (4) casing Plastic 90
(material) (depth)
- (size) if telescope see back.
- (5) screen 20 70
(length) (depth to top)
- 4 Plastic
(size) (material)
- (6) pump 1/2 10
(HP) (yield gpm)
- Electric
(type power)
- (7) electric log no
(yes or no)
- (organization running log)
- (8) how well bottom plugged Stopped

CODED


DRILLERS REMARKS:

MISSISSIPPI BOARD OF WATER COMMISSIONERS
416 NORTH STATE STREET
JACKSON, MISSISSIPPI 39201

PRINTED AND BOUND BY
G. W. BROWN

If well telescopes please sketch and show depths.

GROUND LEVEL

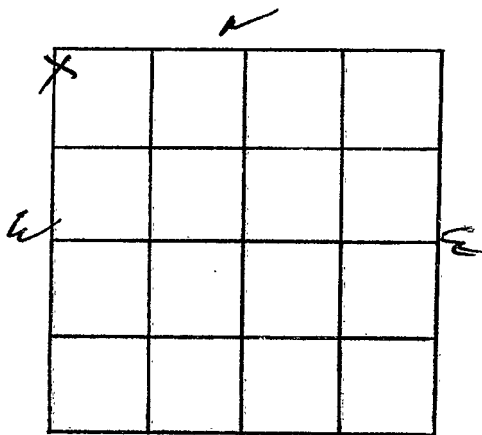

SECTION 28

Please indicate well location X.

ADDITIONAL INFORMATION

If more than one screen,
show locations of each on sketch.