

TATE
A 28
3-7-73

MISSISSIPPI
BOARD OF WATER COMMISSIONERS
416 North State Street
Jackson, Mississippi 39201

WATER WELL DRILLERS LOG

CODED
Jate

3-7-1973 date well completed Bob Smith firm name Jate county well located

LANDOWNER:
New Pleasant Hill Church
Arkabutla, Miss.
(mailing address)

description of formations encountered	from	to
clay dirt		20
yellow clay	20	40
Red sand	40	50
gravel	50	90
Gumbo	90	90

WELL LOCATION:
sec. 28 T 4 N R 9 E
2 3/4 miles NW of Arkabutla
(distance) (direction) (nearest town)

WELL PURPOSE: none
(home, irrigation, municipal, industrial)

- WELL COMPLETION DATA:
- (1) diameter (inches) 4
 - (2) total depth (feet) 90
 - (3) static water level (feet) 69 below top of ground.
 - (4) casing Plastic 90 (material) (depth)
 - (size) if telescope see back.
 - (5) screen 20 70 (length) (depth to top)
 - 4 Plastic (size) (material)
 - (6) pump 1/2 (HP) 10 (yield gpm)
 - Elec (type power)
 - (7) electric log no (yes or no)
 - (organization running log)
 - (8) how well bottom plugged plugged


DRILLERS REMARKS:

EMERGENCY

APR 10 1973

If well telescopes please sketch and show depths.

GROUND LEVEL

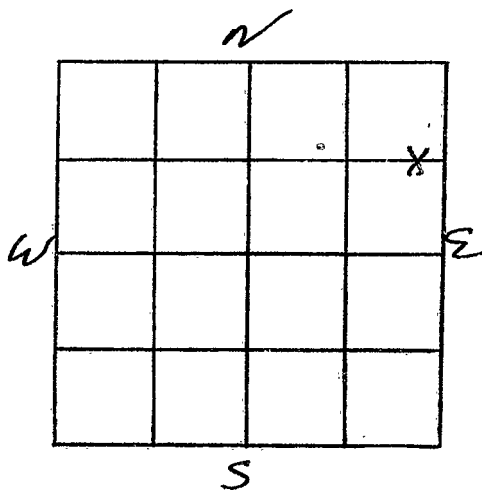

SECTION 28

Please indicate well location X.

ADDITIONAL INFORMATION

If more than one screen,
show locations of each on sketch.