

TATE  
A 29  
3-20-73

MISSISSIPPI  
BOARD OF WATER COMMISSIONERS  
416 North State Street  
Jackson, Mississippi 39201

CODED

WATER WELL DRILLERS LOG

March 20 1973 Shelby Neyman Tate  
date well completed firm name county well located

LANDOWNER: Alvina West  
R.F.D. #1  
Coldwater Miss.  
(mailing address)

Description of formations encountered	from	to
Red clay	0	36
Gravel	30	50
Grey Clay	50	120
Blue Clay	120	190
Grey Sand	190	210

WELL LOCATION:  
sec. 15 T 4 N R 9  
3 1/2 miles N of Arkabutla  
(distance) (direction) (nearest town)

WELL PURPOSE: Home  
(home, irrigation, municipal, industrial)

WELL COMPLETION DATA:

(1) diameter (inches) 2

(2) total depth (feet) 210

(3) static water level (feet) 82 below above top of ground.

(4) casing Galv. 205  
(material) (depth)  
(size) if telescope see back.

(5) screen 5  
(length) (depth to top)  
1/4 Stainless Steel  
(size) (material)

(6) pump 1 (HP) 6 (yield gpm)  
Electric  
(type power)

(7) electric log no  
(yes or no)  
NA  
(organization running log)

(8) how well bottom plugged Rubber Seal


CODED

DRILLERS REMARKS:

APR 16 1973

If well telescopes please sketch and show depths.

GROUND LEVEL

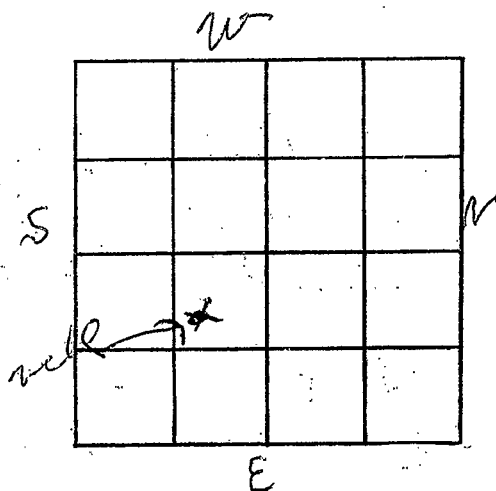

SECTION 15

Please indicate well location X.

ADDITIONAL INFORMATION

If more than one screen,  
show locations of each on sketch.