

TATE
A 30
7-23-73

MISSISSIPPI
BOARD OF WATER COMMISSIONERS
416 North State Street
Jackson, Mississippi 39201

CODED

WATER WELL DRILLERS LOG

June 18 19 73 date well completed
Shelb Negman firm name
Tate county well located

LANDOWNER: James East
Coldwater Miss

(mailing address)

description of formations encountered	from	to
<u>Red clay</u>	<u>0</u>	<u>30</u>
<u>Red sand / gravel</u>	<u>30</u>	<u>80</u>
<u>white sand</u>	<u>80</u>	<u>110</u>

WELL LOCATION:
sec. 23 T 4 N R 9 E
2 1/2 miles N of Coldwater
(distance) (direction) (nearest town)

WELL PURPOSE: water
(home, irrigation, municipal, industrial)

WELL COMPLETION DATA:

- (1) diameter (inches) 4
- (2) total depth (feet) 110
- (3) static water level (feet) 78 below top of ground.
- (4) casing Plastic 110
(material) (depth)
- (size) If telescope see back.
- (5) screen 10 ft
(length) (depth to top)
4 in Plastic
(size) (material)
- (6) pump 3 1.5
(HP) (yield gpm)
Ellis
(type power)
- (7) electric log no
(yes or no)
4W
(organization running log)
- (8) how well bottom plugged Plastic cap


CODED

DRILLERS REMARKS:

JUL 19 1973

If well telescopes please sketch and show depths.

GROUND LEVEL

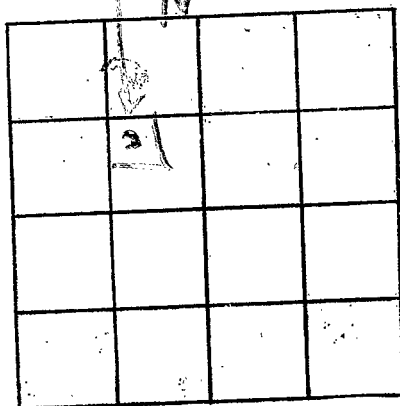

5
SECTION 23

Please indicate well location X.

ADDITIONAL INFORMATION

If more than one screen,
show locations of each on sketch.