

TATE
A 31
7-23-73

MISSISSIPPI
BOARD OF WATER COMMISSIONERS
416 North State Street
Jackson, Mississippi 39201

CODED

WATER WELL DRILLERS LOG

Tate

June 15 1973 date well completed Shelby Regman firm name Tate county well located

LANDOWNER: Thomas F. W. Smith
Coldwater Miss

description of formations encountered	from	to
Red clay	0	40
Red silty sand	40	100
white sand	100	130

(mailing address)

WELL LOCATION:
sec 24 T 4 N R 9 E
2 1/2 miles (distance) N (direction) of Arabola (nearest town)

WELL PURPOSE:
(home, irrigation, municipal, industrial)


- WELL COMPLETION DATA:
- (1) diameter (inches) 4
 - (2) total depth (feet) 130
 - (3) static water level (feet) 80 below top of ground
 - (4) casing (material) Plastic (depth) 130
(size) If telescope see back.
 - (5) screen (length) 10 ft (depth to top) Plastic
(size) (material)
 - (6) pump (HP) 3/4 (yield gpm) 15
Electric (type power)
 - (7) electric log No (yes or no)
No (organization running log)
 - (8) how well bottom plugged Plastic cap

DRILLERS REMARKS:

JUL 19 1973

If well telescopes please sketch and show depths.

GROUND LEVEL

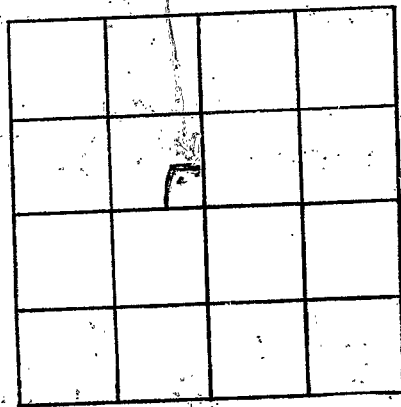

SECTION 24

Please indicate well location X.

ADDITIONAL INFORMATION

If more than one screen,
show locations of each on sketch.