

TATE
A 32
11-15-73

MISSISSIPPI
BOARD OF WATER COMMISSIONERS
416 North State Street
Jackson, Mississippi 39201
CODED

WATER WELL DRILLERS LOG

Nov 15 1973 date well completed
Shells Drilling firm name
Tate county well located

LANDOWNER: Jimmie Sharp
Rt 9, P. 1
Coldwater Miss.
(mailing address)

description of formations encountered	from:	to
	Red clay	0
gravel	40	80
white clay	80	88
white sand	88	120

WELL LOCATION:
sec 26 T 4 N R 9
1 miles (distance) of Arhole (nearest town)

WELL PURPOSE: Home
(home, irrigation, municipal, industrial)

CODED


- WELL COMPLETION DATA:
- (1) diameter (inches) 4
 - (2) total depth (feet) 120
 - (3) static water level (feet) 80 below top of ground.
 - (4) casing Plastic (material) 120 (depth)
 - (size) if telescope see back.
 - (5) screen 16 ft (length) (depth to top)
 - 4 in (size) Plastic (material)
 - (6) pump 3/4 (HP) 20 (yield gpm)
 - Electric (type power)
 - (7) electric log no (yes or no)
 - no (organization running log)
 - (8) how well bottom plugged cap

DRILLERS REMARKS:

DATE 2
1

If well telescopes please sketch and show depths.

GROUND LEVEL

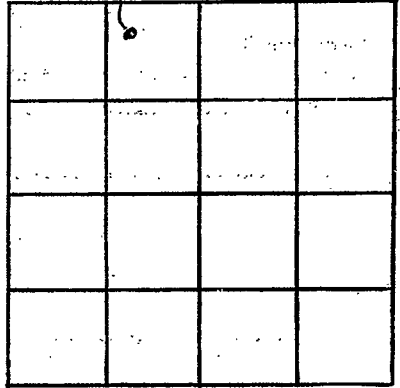

SECTION 26

Please indicate well location X.

ADDITIONAL INFORMATION

If more than one screen, show locations of each on sketch.