

TATE
A 33
6-21-73

MISSISSIPPI
BOARD OF WATER COMMISSIONERS
416 North State Street
Jackson, Mississippi 39201

CODED

WATER WELL DRILLERS LOG

6-21-1973 date well completed
Bob Smith firm name
Tate county well located

LANDOWNER:
O. the Payne
Collwats - min.
(mailing address)

WELL LOCATION:
sec. 23 1/2 N. R. 9 E
(distance) miles (direction) of Arkabutla
(nearest town)

WELL PURPOSE:
(home, irrigation, municipal, industrial)

- WELL COMPLETION DATA:
- (1) diameter (inches) 4
 - (2) total depth (feet) 205
 - (3) static water level (feet) 100 below top of ground.
 - (4) casing Plastic 305
(material) (depth)
 - (size) If telescope see back.
 - (5) screen 20 185
(length) (depth to top)
 - 4 Plastic
(size) (material)
 - (6) pump 1/2 10
(HP) (yield gpm)
 - Elec.
(type power)
 - (7) electric log No
(yes or no)
 - (organization running log)
 - (8) how well bottom plugged plugged

description of formations encountered	from	to
clay dirt	10	15
red sand	15	20
yellow clay	20	50
hard rock	50	51
gravel	50	70
blue clay	70	170
gray sand	170	205


CODED

DRILLERS REMARKS:

ORD 27 1973

If well telescopes please sketch and show depths.

GROUND LEVEL

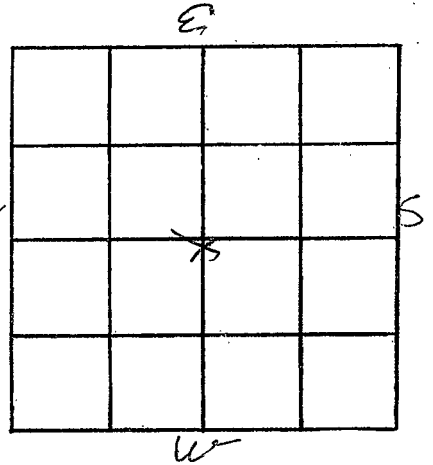

SECTION 23

Please indicate well location X.

ADDITIONAL INFORMATION

If more than one screen,
show locations of each on sketch.