

LATE
A3A
6-2-73

MISSISSIPPI
BOARD OF WATER COMMISSIONERS
416 North State Street
Jackson, Mississippi 39201

CODED

WATER WELL DRILLERS LOG

6-2-73 date well completed Bob Smith firm name Lata county well located

LANDOWNER:
W. T. Smith
Coldwater, Miss.
(mailing address)

description of formations encountered	from	to
Clay just	40	18
yellow clay	18	35
gravel	35	70

WELL LOCATION:
sec. 15 T 4 N R 9 E
3 miles NW of Arkabutla
(distance) (direction) (nearest town)

WELL PURPOSE:
Home
(home, irrigation, municipal, industrial)

- WELL COMPLETION DATA:
- (1) diameter (inches) 4
 - (2) total depth (feet) 70
 - (3) static water level (feet) 35 below top of ground.
 - (4) casing: Plaster 70 (material) (depth)
 - _____ If telescope see back. (size)
 - (5) screen 20 50 (length) (depth to top)
 - 4 Plaster (size) (material)
 - (6) pump 1/2 10 (HP) (yield gpm)
 - Elic (type power)
 - (7) electric log 70 (yes or no)
 - _____ (organization running log)
 - (8) how well bottom plugged plugged


CODED

DRILLERS REMARKS:

SEP 27 1973

If well telescopes please sketch and show depths.

GROUND LEVEL

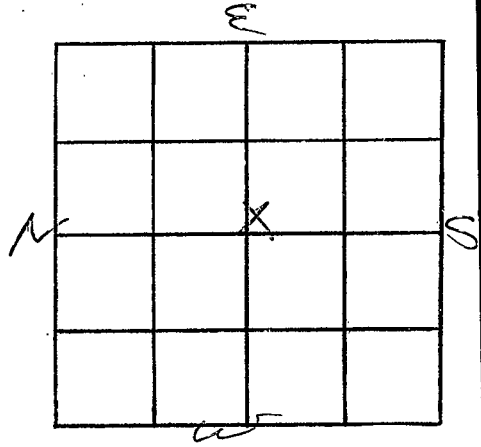

SECTION 15

Please indicate well location X.

ADDITIONAL INFORMATION

If more than one screen,
show locations of each on sketch.