

TATE
A36
12-5-72

MISSISSIPPI
BOARD OF WATER COMMISSIONERS
416 North State Street
Jackson, Mississippi 39201

CODED

WATER WELL DRILLERS LOG

Dec 5 1972 Shelly Neyman Tate
date well completed firm name county well located

LANDOWNER: U.S. Government
Leased by H.C. Campbell
P.O. Box 1701 - Coldwater, Miss.
(mailing address)

description of formations encountered	from	to
Red clay	0	40
Red sand & gravel	40	70
Blue clay	70	120
White sand	120	131

WELL LOCATION:
sec. 9 T 4 N R 9 E
5 miles N of Osbaston
(distance) (direction) (nearest town)

WELL PURPOSE: drone
(home, irrigation, municipal, industrial)


- WELL COMPLETION DATA:
- (1) diameter (inches) 2
 - (2) total depth (feet) 131
 - (3) static water level (feet) 80 below top of ground.
 - (4) casing Galvinox (material) 126 (depth)
if telescope see back.
(size)
 - (5) screen 5ft (length) (depth to top)
1 1/4 (size) Stainless Steel (material)
 - (6) pump 3/4 (HP) 4 (yield gpm)
Electric (type power)
 - (7) electric log no (yes or no)
no (organization running log)
 - (8) how well bottom plugged Rubber Seal

DRILLERS REMARKS:

JAN 10 1973

If well telescopes please sketch and show depths.

GROUND LEVEL

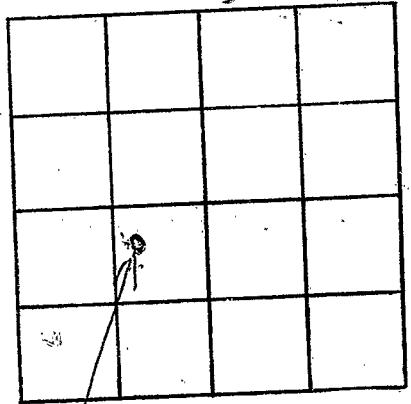

SECTION 9

Please indicate well location X.

ADDITIONAL INFORMATION

If more than one screen, show locations of each on sketch.