

**LATE**  
**A37**  
**7-8-73**

MISSISSIPPI  
 BOARD OF WATER COMMISSIONERS  
 416 North State Street  
 Jackson, Mississippi 39201

**CODED**

WATER WELL DRILLERS <sup>106</sup> *Jim Kerif*  
 date well completed 7/8 19 73 firm name Jim Kerif county well located DeWitt County

LANDOWNER: TOM IRBY  
~~AT Estate~~  
 (mailing address)

description of formations encountered	from	to
<u>Sand</u>	<u>0</u>	<u>20</u>
<u>Sand &amp; gravel</u>	<u>20</u>	<u>90</u>
<u>Sand</u>	<u>90</u>	<u>105</u>

WELL LOCATION:  
 sec. 33 4 N 9 E  
2 miles (distance) W (direction) Rockwell (nearest town)

WELL PURPOSE: drinking  
 (home, irrigation, municipal, industrial)

WELL COMPLETION DATA: 7-8-73

- (1) diameter (inches) 2
- (2) total depth (feet) 105
- (3) static water level (feet) 90 <sup>(below)</sup> <sub>(above)</sub> top of ground.
- (4) casing 90 (material) 105 (depth)
- 1/2 (size) if telescope see back.
- (5) screen 1/2 (length) 90 (depth to top)
- 17 (size) 17 (material)
- (6) pump 1/2 (HP) 250 (yield gpm)
- (type power)
- (7) electric log yes (yes or no)
- (organization running log) BN
- (8) how well bottom plugged BN


**CODED**

MISS. BD. OF WATER COMMISSIONERS  
 JAN 3 1974

DRILLERS REMARKS:

If well telescopes please sketch and show depths.

GROUND LEVEL

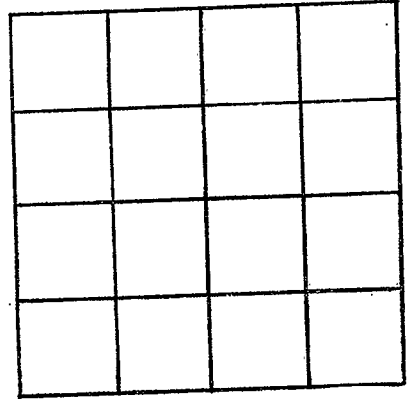

SECTION \_\_\_\_\_

Please indicate well location X.

ADDITIONAL INFORMATION

If more than one screen, show locations of each on sketch.