

MISSISSIPPI  
 BOARD OF WATER COMMISSIONERS  
 416 North State Street  
 Jackson, Mississippi 39201

CODED

WATER WELL DRILLERS LOG

LATE  
 A 39  
 8-29-73

8-29-1973 date well completed      Bob Smith firm name      Tate county well located

LANDOWNER:  
 F. F. Veazy  
 Coldwater - Miss.  
 (mailing address)

description of formations encountered	from	to
Top soil	0'	5'
Clay	5'	20'
Sand	20'	95'

WELL LOCATION:  
 sec. 9 T. 4 N. R. 9 E.  
 10 miles NW of Coldwater  
 (distance) (direction) (nearest town)

WELL PURPOSE: None  
 (home, irrigation, municipal, industrial)

WELL COMPLETION DATA:

(1) diameter (inches) 4

(2) total depth (feet) 95

(3) static water level (feet) 35 below top of ground.

(4) casing Plastic 95 (material) (depth)

(size) If telescope see back.

(5) screen 20 75 (length) (depth to top)

4 Plastic (size) (material)

(6) pump 3/4 15 (HP) (yield gpm)


Elec (type power)

(7) electric log no (yes or no)

(organization running log)

(8) how well bottom plugged plugged

CODED

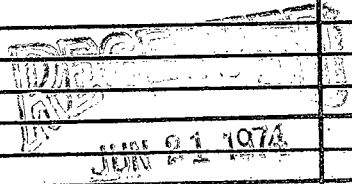

DRILLERS REMARKS:

If well telescopes please sketch and show depths.

GROUND LEVEL

	X		

SECTION 9

Please indicate well location X.

ADDITIONAL INFORMATION

If more than one screen,  
show locations of each on sketch.