

TATE
A 40
10/74

MISSISSIPPI
BOARD OF WATER COMMISSIONERS
416 North State Street
Jackson, Mississippi 39201

CODED

WATER WELL DRILLERS LOG

19 Bob Smith & Son Tate
date well completed firm name county well located

LANDOWNER: <u>Joseph W. Conway</u>	description of formations encountered	from	to
(mailing address)			
<u>Route 1 Box 170</u>	<u>Red Clay</u>	<u>0</u>	<u>28</u>
<u>Collwatu, Ms.</u>	<u>Sand & Gravel</u>	<u>28</u>	<u>70</u>

WELL LOCATION:
sec. 21 T 4 N R 9 E
4 miles N of Archieville
(distance) (direction) (nearest town)

WELL PURPOSE: Home
(home, irrigation, municipal, industrial)

- WELL COMPLETION DATA:
- (1) diameter (inches) 4
 - (2) total depth (feet) 70
 - (3) static water level (feet) 40 below top of ground.
 - (4) casing Plastic, 70'
(material) (depth)
(size) if telescope see back.
 - (5) screen 4" 10'
(length) (depth to top)
4" Plastic
(size) (material)
 - (6) pump 1/2 12
(HP) (yield gpm)
electric
(type power)
 - (7) electric log No
(yes or no)


(organization running log)
(8) how well bottom plugged Plugged

DRILLERS REMARKS:

RECEIVED
SEP 26 1974

If well telescopes please sketch and show depths.

GROUND LEVEL

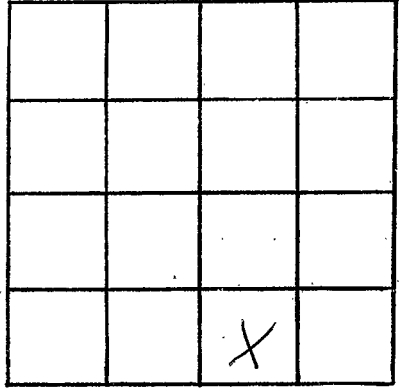

SECTION 21

Please indicate well location X.

ADDITIONAL INFORMATION

If more than one screen, show locations of each on sketch.