

LATE
A 41
9-4-74

MISSISSIPPI
BOARD OF WATER COMMISSIONERS
416 North State Street
Jackson, Mississippi 39201

CODED

WATER WELL DRILLERS LOG

9-4 1974 Bob Smith + Son Lata
date well completed firm name county well located

LANDOWNER: Doug Barrett
Route 1 Box 95
Caldwater, Miss.
(mailing address)

description of formations encountered	from	to
<u>TOP Soil</u>	<u>0</u>	<u>40</u>
<u>Sand clay streaky</u>	<u>40</u>	<u>80</u>
<u>Red sand + gravel</u>	<u>80</u>	<u>110</u>
<u>Deep white sand</u>	<u>110</u>	<u>135</u>
<u>White sand</u>	<u>135</u>	<u>156</u>

WELL LOCATION:
sec. 27 T 4 N R 1 E
2 miles miles 7 of Arbuckle
(distance) (direction) (nearest town)

WELL PURPOSE:
(home, irrigation, municipal, industrial)

- WELL COMPLETION DATA:
- (1) diameter (inches) 4"
 - (2) total depth (feet) 156
 - (3) static water level (feet) 52 below above top of ground.
 - (4) casing Plastic, 156,
(material) (depth)
(size) If telescope see back.
 - (5) screen 4", 146'
(length) (depth to top)
4, Elastic
(size) (material)
 - (6) pump 1/3, 10
(HP) (yield gpm)
Electric
(type power)
 - (7) electric log No
(yes or no)

(organization running log)
(8) how well bottom plugged Plugged


DRILLERS REMARKS:

RECEIVED
SEP 26 1974

MISS. BD. OF WATER COMM

If well telescopes please sketch and show depths.

GROUND LEVEL

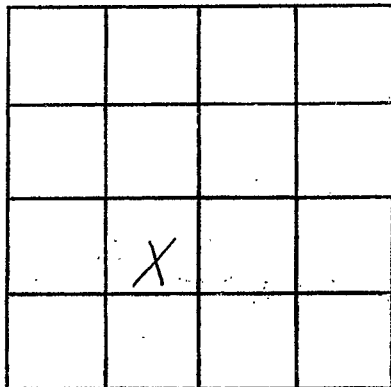

SECTION 27

Please indicate well location X.

ADDITIONAL INFORMATION

If more than one screen, show locations of each on sketch.