

Date  
A 43  
3-20-75

MISSISSIPPI  
BOARD OF WATER COMMISSIONERS  
416 North State Street  
Jackson, Mississippi 39201

CODED

WATER WELL DRILLERS LOG


3-20-1975 W.A. Mason Water Well Contractor  
date well completed firm name county well located

LANDOWNER:	description of formations encountered	from	to
High Arch RFD, Caldwate Miss. (mailing address)	Clay first	70	80
	Clay	80	60
	gump	60	84
	yellow sandstone	84	93
	white clay	84	93
<b>WELL LOCATION:</b>			
sec. 15 T 4 N R 9 E 5 1/2 miles NW of Arkabutla (distance) (direction) (nearest town)			
<b>WELL PURPOSE:</b> Home (home, irrigation, municipal, industrial)			
<b>WELL COMPLETION DATA:</b>			
(1) diameter (inches) 4"			
(2) total depth (feet) 93'			
(3) static water level (feet) 70' below top of ground.			
(4) casing Plastic 83' (material) (depth) 4" if telescope see back. (size)			
(5) screen 10' 83' (length) (depth to top) 4" plastic (size) (material)			
(6) pump 1/3 5 (HP) (yield gpm)			
(7) electric log No (yes or no)			
(organization running log)			
(8) how well bottom plugged Clay on screen			
<b>DRILLERS REMARKS:</b>			

REGISTERED  
MAY 12 1975

If well telescopes please sketch and show depths.

GROUND LEVEL

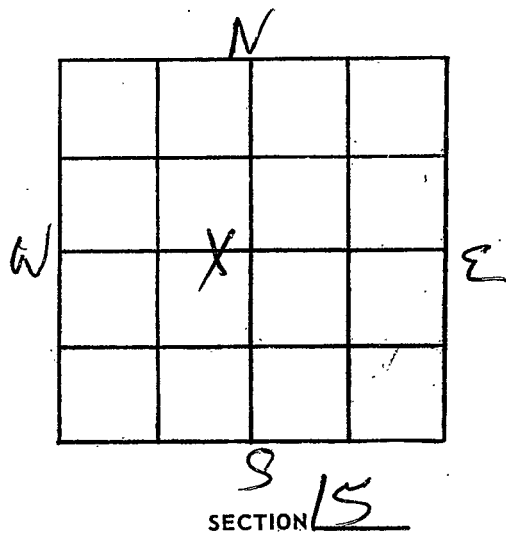

Please indicate well location X.

ADDITIONAL INFORMATION

If more than one screen,  
show locations of each on sketch.