

Depth, log,
and screen Do not
agree

Date
A 44
6-30-75

MISSISSIPPI
BOARD OF WATER COMMISSIONERS
416 North State Street
Jackson, Mississippi 39201
WATER WELL DRILLERS LOG

CODED

6-30-1975 date well completed Hinks W.M.Co. firm name Tate county well located

LANDOWNER:	description of formations encountered	from	to
Dabner Hill	Red clay	0	45
Rt 1 Box 150, Coldwater, Miss. (mailing address)	Red clay + Sand	45	60
WELL LOCATION: sec 31 T 4 N R 9 E 15E 4 miles W of Abbeville (distance) (direction) (nearest town)	Red clay + gravel	60	90
WELL PURPOSE: Home (home, irrigation, municipal, industrial)	White sand + gravel	90	105
WELL COMPLETION DATA: (1) diameter (inches) 4 1/2 (2) total depth (feet) 300 (3) static water level (feet) 170 below top of ground. (4) casing Plastic, 170 (material) (depth) (size) if telescope see back. (5) screen 7 1/4, 16 3/4 (length) (depth to top) 4 1/2, Shovel (size) (material) (6) pump 1/2 (HP) 10 (yield gpm) Electric, 250 (type power) (7) electric log 40 (yes or no) (organization running log) (8) how well bottom plugged Cap	White sand + black clay	105	120
	Black clay	120	255
	Black clay + white sand	255	270
	White sand	270	300
DRILLERS REMARKS:			


RECEIVED

JUL 21 1975

MISS. BD. OF WATER COMMISSIONERS

If well telescopes please sketch and show depths.

GROUND LEVEL

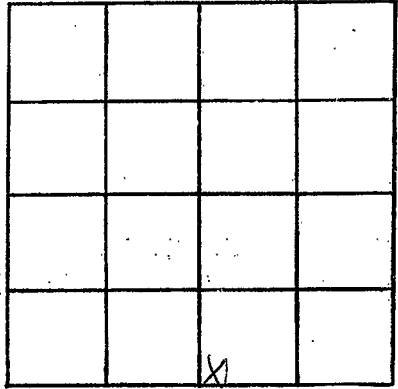

SECTION 31

Please indicate well location X.

ADDITIONAL INFORMATION

If more than one screen, show locations of each on sketch.