

Date
A 45
7-3-75

MISSISSIPPI
BOARD OF WATER COMMISSIONERS
416 North State Street
Jackson, Mississippi 39201

WATER WELL DRILLERS LOG

7-3-75 Hanks Well Co. State
date well completed firm name county well located

LANDOWNER:

R.E. Swift

(mailing address)

WELL LOCATION:

sec. 15 T. 24 N. R. 9 E. 156
4 miles N of Osburn
(distance) (direction) (nearest town)

WELL PURPOSE:

(home, irrigation, municipal, industrial)

WELL COMPLETION DATA:

- (1) diameter (inches) 4 1/2 in.
- (2) total depth (feet) 200
- (3) static water level (feet) 120 below top of ground.
- (4) casing Plastic, 200
(material) (depth)
- (size) If telescope see back.
- (5) screen 7 ft, 193
(length) (depth to top)
4 1/2 in. Gravel
(size) (material)
- (6) pump 1/2 10
(HP) (yield gpm)
Electric, 220
(type power)
- (7) electric log Y/N
(yes or no)
- (organization running log)
- (8) how well bottom plugged cap

description of formations encountered

from to

red clay CODED	0	30
Red Sand	30	45
White Sand + Black Clay	45	60
Black Clay	60	165
Black Clay + White Sand	165	180
White Sand	180	200


RECEIVED
JUL 21 1975

DRILLERS REMARKS:

MISS. BD. OF WATER

If well telescopes please sketch and show depths.

GROUND LEVEL

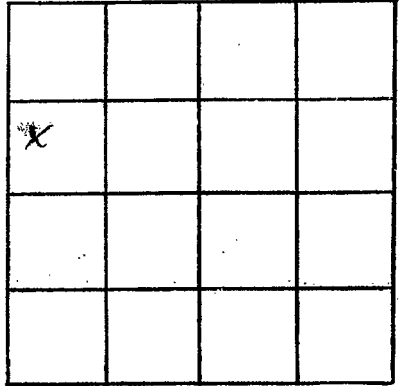

SECTION 15

Please indicate well location X.

ADDITIONAL INFORMATION

If more than one screen,
show locations of each on sketch.