

Date
A 46
7-17-75

MISSISSIPPI
 BOARD OF WATER COMMISSIONERS
 416 North State Street
 Jackson, Mississippi 39201

CODED

WATER WELL DRILLERS LOG

July 17 1975 Shelby Newman Date
 date well completed firm name county well located

LANDOWNER: Robert Jones
Rt. 1, D. 1 -
Coldwater Miss.
 (mailing address)

description of formations encountered	from	to
<u>Red clay</u>	<u>0</u>	<u>40</u>
<u>shale</u>	<u>40</u>	<u>75</u>
<u>white clay</u>	<u>75</u>	<u>90</u>
<u>clear white sand</u>	<u>90</u>	<u>110</u>

WELL LOCATION:
 sec. 33 T 4 N R 9 E 15E
S W
1 miles S.W. of Arhatton
 (distance) (direction) (nearest town)

WELL PURPOSE: Home
 (home, irrigation, municipal, industrial)

CODED

WELL COMPLETION DATA:

(1) diameter (inches) 4

(2) total depth (feet) 110

(3) static water level (feet) 75 below above top of ground.

(4) casing Plastic 110
 (material) (depth)

 if telescope see back.
 (size)

(5) screen 10 (length) (depth to top)
4 (size) Plastic (material)


(6) pump 3/4 (HP) 15 (yield gpm)
Electric (type power)

(7) electric log no
 (yes or no)

 (organization running log)


(8) how well bottom plugged 4 in Plastic cap

DRILLERS REMARKS:

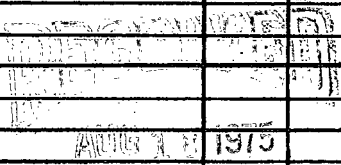

If well telescopes please sketch and show depths.

GROUND LEVEL

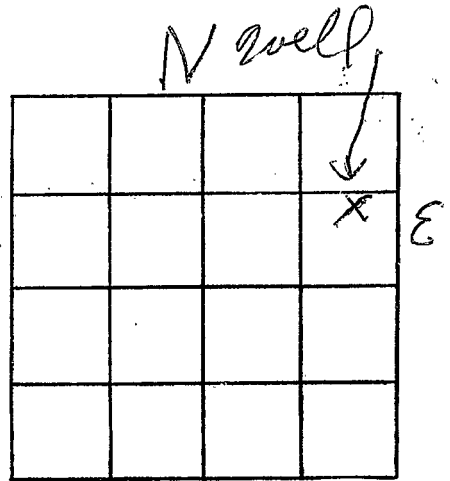

5
SECTION 33

Please indicate well location X.

ADDITIONAL INFORMATION

If more than one screen,
show locations of each on sketch.