

Late
A-47
7-28-75

MISSISSIPPI
 BOARD OF WATER COMMISSIONERS
 416 North State Street
 Jackson, Mississippi 39201

WATER WELL DRILLERS LOG

CODED

July 28 1975 Shelby Newman Late
 date well completed firm name county well located

LANDOWNER: <u>Kathleen Newman</u>	description of formations encountered	from	to
<u>Arhobutla Miss</u> (mailing address)		<u>Red clay</u>	<u>0</u>
WELL LOCATION: sec <u>26</u> T <u>4</u> N R <u>9</u> E <u>15E</u> S W	<u>white clay</u>	<u>40</u>	<u>70</u>
<u>1</u> miles <u>N</u> of <u>Arhobutla</u> (distance) (direction) (nearest town)	<u>Gravel & sand</u>	<u>70</u>	<u>130</u>
WELL PURPOSE: <u>Home use</u> (home, irrigation, municipal, industrial)	<u>clear white sand</u>	<u>130</u>	<u>150</u>

CODED

WELL COMPLETION DATA:

(1) diameter (inches) 4

(2) total depth (feet) 150

(3) static water level (feet) 80 below above top of ground.

(4) casing Plastic, 150
(material) (depth)
(size) if telescope see back.

(5) screen 70
(length) (depth to top)
4 Plastic
(size) (material)

(6) pump 3/4 15
(HP) (yield gpm)
Electric
(type power)

(7) electric log No
(yes or no)

(organization running log)


(8) how well bottom plugged if in Plastic cap

RECEIVED
 MISSISSIPPI
 AUG 18 1975

DRILLERS REMARKS:

If well telescopes please sketch and show depths.

GROUND LEVEL

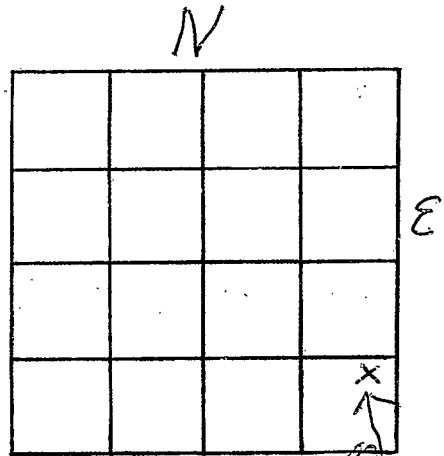

S well
SECTION 26

Please indicate well location X.

ADDITIONAL INFORMATION

If more than one screen,
show locations of each on sketch.