




If well telescopes please sketch and show depths.

GROUND LEVEL

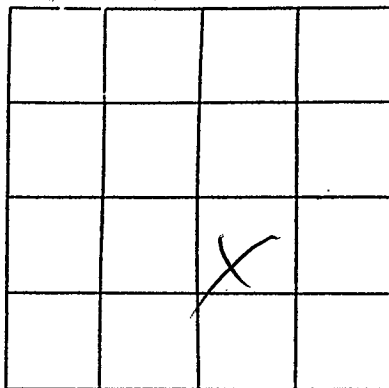

SECTION A-29

Please indicate well location X.

Pump Capacity (GPM)	No. of Stages	Setting Depth
<u>10</u>	<u>12</u>	<u>100</u> FT.
PUMP TEST		
Well yielded <u>15</u> GPM with		
a drawdown of <u>4</u> ft.		
after <u>1</u> hours of pumping		

LOG DATA

TYPE OF LOG RUN (Circle One):	No Log Run,
Electric, Gamma Ray, Density, Sonic, Neutron,	
Other (Describe) _____	
Name of Organization Running Log	

GEOLOGIC DATA (Office Use Only)

Surface Elev.	Geologic Unit	Unit Thickness	Depth to Top
Subs. SWL	Date	Analysis	Aquifer Test

Driller's Remarks

\_\_\_\_\_

\_\_\_\_\_

If more than one screen, show location of each on sketch.