

State Well Report

Part 1

Mississippi Department of Environmental Quality
Office of Land and Water Resources
P.O. Box 10631
Jackson, MS 39289-0631
(601)961-5210
(601)354-6938 (fax)

For Office Use Only:

Aquifer: _____
Well #: A-68
L. S. Elevation: _____
E-log #: _____

County: TATE
Permit #: Smith Well Drilling
Driller: BOB SMITH
Date drilling completed: 8-4-04

State Law requires that this report be prepared by the driller in detail and filed with the Department within 30 days of completion of drilling of the well.

Well Owner Information	Well Location
Owner Name: <u>William Konegay</u>	Latitude: _____ Longitude: _____
Mailing Address: <u>231 BEND RD</u>	Method of Lat/Long (circle one): Conventional Survey, USGS quad, Hand-held GPS, Survey-grade GPS
<u>Georgetown MS 38618</u>	_____ 1/4 _____ 1/4 Sec <u>A21</u> Twn <u>T4S</u> Rng <u>R9W</u>
City State Zip Code	Distance Direction Nearest Town
Telephone No. <u>(662) 562-4681</u>	<u>2</u> Miles <u>NEW</u> of <u>ANKARBUTLA</u>

Well Data

Purpose of Well (circle one) Home Industrial Public Supply Irrigation Fish Culture Other: _____

Date well drilling started: 8-4-04 Date well drilling completed: 8-4-04

If flowing, method of flow regulation: Valve _____ Other (describe) _____

Static Water Level: 80 feet above or below (circle one) land surface Date measured: 8-4-04

Method of Measurement (circle one) steel tape electric tape air line other: _____

Hole depth: 151 Well depth: 151 Well grouted to a depth of 10 feet

Type of grout (circle one): Cement Bentonite Mix

Casing length: 131 feet Casing diameter: 4 inches Type of casing: PUC

Screen length: 20 feet Screen diameter: 4 inches Type of screen: PUC

Screen slot size: 14 mesh inches Setting depth: From 131 feet to 151 feet

Type of completion (circle all applicable): Gravel packed Underreamed Telescoped Open hole Natural Development
Other (describe): WASHED SAND

Top of lap pipe or reduction in casing: _____ feet. If telescoped or more than one screen, describe on back of page

Logs run (circle all applicable): No log run Electric Gamma Ray Density Sonic Neutron Other: _____

Name of organization running log(s): _____

RECEIVED
SEP 01 2004
BY: OLWR

I certify that the well was drilled, constructed, and completed in accordance with all applicable requirements of the Mississippi Department of Environmental Quality and/or the Mississippi Department of Health regulations and state laws.

ROBERT SMITH 0-645 _____
Print Name of Water Well Contractor and License No. Signature of Water Well Contractor

STATE WELL REPORT

Part 2

Pump Installer's Completion Report
 Mississippi Department of Environmental Quality
 Office of Land and Water Resources
 P.O. Box 10631
 Jackson, MS 39289-0631
 (601)961-5210
 (601)354-6938 (fax)

County: TATE
 Permit #: _____
 Driller: BOB SMITH
 Date completed: 8-4-04

For Office Use Only:

Aquifer: _____
 Well #: A-68
 Elevation: _____

This report should be prepared by the pump installer in detail and filed with the Department within 30 days of the installation of pump.

Well Owner Information	Well Location
Owner Name: <u>William Korwegaj</u>	Latitude: _____ Longitude: _____
Mailing Address: <u>731 Beno Rd.</u>	Method of Lat/Long (circle one): Conventional Survey, USGS quad, Hand-held GPS, Survey-grade GPS
<u>COLUMBIA, MS. 38618</u>	<u>1/4 1/4 Sec A21 Twn 745 Rng 29W</u>
City State Zip Code	Distance Direction Nearest Town
Telephone No. <u>(662) 562-4681</u>	<u>2 Miles NW of ARKIBOTCA</u>

Pump Type Circle one	Power Type Circle one
Air Lift Jet <input checked="" type="radio"/> <u>Submersible</u>	Diesel Engine Gasoline Engine Natural Gas
Bucket Piston Turbine	<input checked="" type="radio"/> <u>Electric Motor</u> Hand Tractor PTO
Centrifugal Rotary Flowing Well	Windmill Other (specify): _____
Other (specify): _____	Horse Power Rating of Motor: <u>3/4</u>
Date Pump Installed: <u>8-4-04</u>	Setting Depth: <u>100</u> feet
Rated Pump Capacity: <u>12</u> Gallons Per Minute	Number of Stages: <u>12</u>

RECEIVED
 SEP 01 2004
 BY: OLWR

Pump Test Data	Method of Measuring Water Level Circle one
Date Well Tested: <u>8-4-04</u>	Air Line <input checked="" type="radio"/> <u>Electric Measuring Line</u> Steel Tape
Static Water Level (A): <u>80</u> Feet Below Land Surface	Other (specify): _____
Pumping Water Level (B): <u>86</u> Feet Below Land Surface	For flowing well, measured shut in head: _____ feet
Drawdown [(B) - (A)]: <u>6</u> Feet Below Land Surface	Well yielded <u>14</u> GPM with a drawdown of
Test Pumping Rate: <u>14</u> Gallons Per Minute	<u>6</u> feet after <u>4</u> hours of pumping
Duration of Pump Test (minimum 4 hours): <u>4</u> hours	

I HEREBY CERTIFY that the above statements are true to the best of my knowledge.

ROBERTO SMITH 0645
 Print Name of Pump Installer and License No. (if applicable)

[Signature]
 Signature of Pump Installer

If well telescopes please sketch below and show depths.


Ground Level

A-68

Description of Formations Encountered	From	To
Brown clay	0	5
RED + YELLOW CLAY	5	36
RED SAND + GRAVEL	36	72
WHITE CLAY	72	110
WHITE CLAY + SAND	110	130
WHITE SAND	130	151
ROCK	151	

If more than one screen, show location of each on sketch

Sketch the property layout and include the following: 1) the well location; 2) any permanent structures on the property that may aid in locating the well; 3) any roads, power lines, or other items that may aid in locating the property and the well; 4) indicate direction.

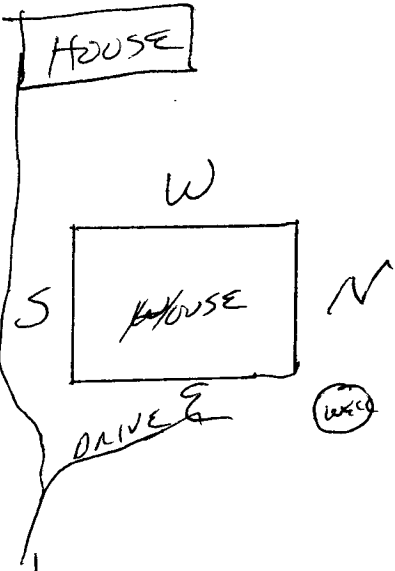

RECEIVED
SEP 01 2004
BY: OLWR

Landowner Name: WILLIAM ROMEBA

[Signature]
Signature of Water Well Contractor