

Tate  
A 2000  
12-66

MISSISSIPPI  
BOARD OF WATER COMMISSIONERS  
416 North State Street  
Jackson, Mississippi 39201

WATER WELL DRILLERS LOG

Dec 1 1966 date well completed  
Shelby Neyman firm name  
Tate county well located


LANDOWNER: Miller Levy  
R. F. D. - 1  
Coldwater Miss  
(mailing address)

WELL LOCATION:  
sec. 10 T. 4 N. R. 9 E. S. 4 W.  
4 miles North of Arkham  
(distance) (direction) (nearest town)

WELL PURPOSE: Home  
(home, irrigation, municipal, industrial)

- WELL COMPLETION DATA:
- (1) diameter (inches) 2
  - (2) total depth (feet) 133
  - (3) static water level (feet) 74 below top of ground. 2 meters
  - (4) casing 2 in. 126 ft (material) (depth)
  - no (size) if telescope see back.
  - (5) screen 6 ft 126 (length) (depth to top)  
90% metal (size) (material)
  - (6) pump 1/2 hp 4 (HP) (yield gpm)  
Electricity (type power)
  - (7) electric log no (yes or no)  
no (organization running log)
  - (8) how well bottom plugged with metal point.


description of formations encountered	from	to
	ft	ft
Red clay	0	30
Red gravel	30	60
Thin white clay	60	70
mixture of white sand & white clay	70	118
white sand	118	133

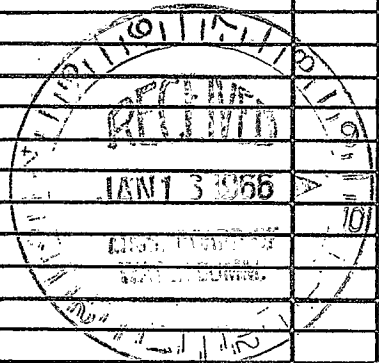

DRILLERS REMARKS:

If well telescopes please sketch and show depths.

GROUND LEVEL

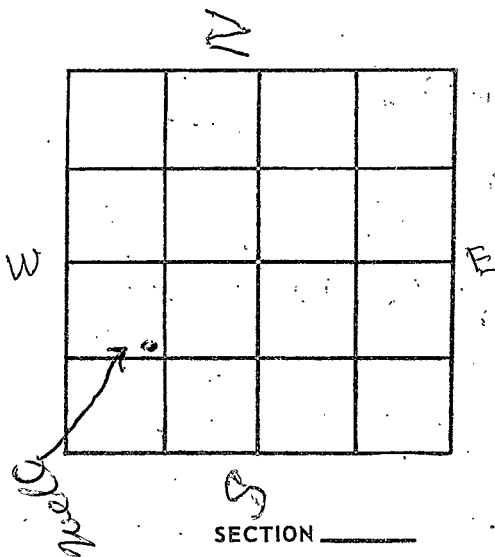

SECTION \_\_\_\_\_

Please indicate well location X.

ADDITIONAL INFORMATION

If more than one screen, show locations of each on sketch.