

MISSISSIPPI BOARD OF WATER COMMISSIONERS

WATER WELL DRILLERS LOG

Date: Sept 9, 1966, Driller: Shelly Newman County Fate
(Name)


(1) Owner of Land:	Description & Color of Materials Sand, Clay, Red Clay, Shell, etc.	Thick- ness Feet	Depth Feet
<u>Lewis Brown</u> <small>(Name)</small> <u>Richard Miss</u> <small>(Address)</small>	<u>Dark clay</u>	<u>40</u>	<u>40</u>
(2) Location: <u>1/4, SW 1/4, Sec 26 T4R10W</u> <u>1/2</u> miles <u>East</u> of <u>Prichard</u> <small>(distance) (direction) (Nearest Town)</small>	<u>Slopy Sand</u>	<u>20</u>	<u>60</u>
(3) Topography: <u>Flat</u> <small>(Hilly) (Flat) (Level)</small>	<u>Clear Sand</u>	<u>11</u>	<u>71</u>
(4) Purpose of Well: <u>Domestic</u> <small>(Domestic Irrigation Municipal, Industrial, Other)</small>	<u>Plye</u>		

Information upon completion of well:

- (1) Diameter 2 inches.
- (2) Total Depth 71 feet.
- (3) Water Level 22 feet below top of ground.
- (4) Cased to 63, Size 2 in.
- (5) Screen: Size 90, Length 6 ft.
- (6) Were any formations sealed against pollution?
 yes, No no.

If YES depth of formation _____
 Why _____

Drillers Remarks: _____

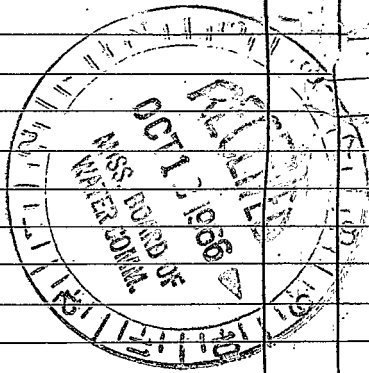

(Use Back Side)

Well No.

[Faint, illegible text, possibly bleed-through from the reverse side of the page]

[Faint handwritten notes or signatures]

[Faint, illegible text, possibly bleed-through from the reverse side of the page]