

Tate  
A 2002  
1-67

MISSISSIPPI  
BOARD OF WATER COMMISSIONERS  
416 North State Street  
Jackson, Mississippi 39201

WATER WELL DRILLERS' LOG

Jan 9 1967 date well completed  
Shelly Newman  
Tate county well located

LANDOWNER:	description of formations encountered	from	to
Thomas Marpuell R. F. D. Coldwater Miss (mailing address)	Red clay	0	25
	Grey clay	25	80
	Arbuckle mixture of clay & sand	80	116
	White Sand	116	126

WELL LOCATION:

sec. 24 T. 4 S. R. 9 E.  
2 miles N, E. of Arbuckle  
(distance) (direction) (nearest town)

WELL PURPOSE:

Home (home, irrigation, municipal, industrial)


WELL COMPLETION DATA:

- (1) diameter (inches) 2
- (2) total depth (feet) 126
- (3) static water level (feet) 72 below top of ground.
- (4) casing Metal, 120 (material) (depth)
- (5) screen 6 ft, 120 (length) (depth to top)
- 90% Metal (size) (material)
- (6) pump 1/2 HP, 4 (yield gpm)
- Electric (type power)
- (7) electric log No (yes or no)
- No (organization running log)
- (8) how well bottom plugged Metal Point

DRILLERS REMARKS:

If well telescopes please sketch and show depths.

GROUND LEVEL

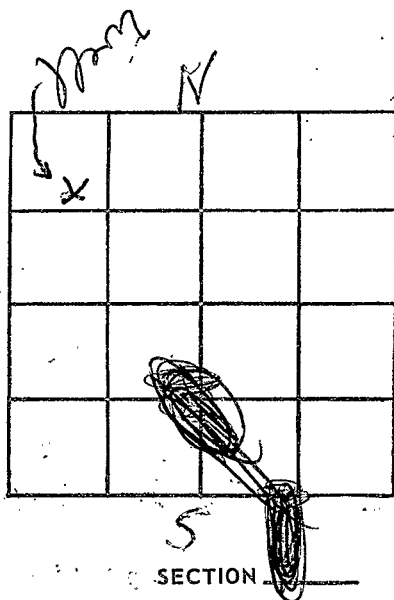

SECTION

Please indicate well location X.

ADDITIONAL INFORMATION

If more than one screen, show locations of each on sketch.