

Late
 A 2003
 6-67

MISSISSIPPI
 BOARD OF WATER COMMISSIONERS
 416 North State Street
 Jackson, Mississippi 39201

WATER WELL DRILLERS LOG

June 1 19 67 Shelby Noyman Late
 date well completed firm name county well located

LANDOWNER: Eddie Hubbard
 Coldwater Miss
 R. F. D. - 1
 (mailing address)

WELL LOCATION:
 sec. 29 T. 4 S. R. 9 W.
 5 miles W of Arkabutla
 (distance) (direction) (nearest town)

WELL PURPOSE: Home
 (home, irrigation, municipal, industrial)

WELL COMPLETION DATA:
 (1) diameter (inches) 2 in
 (2) total depth (feet) 238
 (3) static water level (feet) 85 below top of ground.
 (4) casing Galvanize (material) (depth)

if telescope see back.
 (5) screen 60 ga. 231 (size) (length) (depth to top)


(6) pump 1/2 HP (size) (material) (yield gpm)
 Electric (type power)

(7) electric log No (yes or no)
 No (organization running log)

(8) how well bottom plugged

description of formations encountered	from	to
Red Clay	60	60
Red Sand & Gravel	60	105
White Clay	105	220
White Sand	220	238

DRILLERS REMARKS:

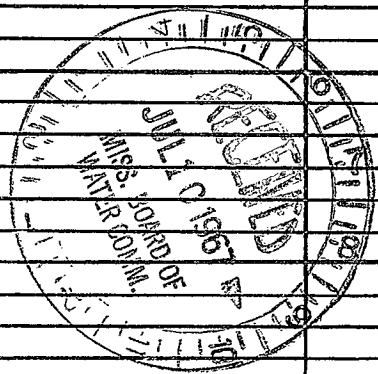

If well telescopes please sketch and show depths.

GROUND LEVEL

Well → X

SECTION 29

Please indicate well location X.

ADDITIONAL INFORMATION

SE Cor SW⁴ NW⁴ Sec 29

If more than one screen, show locations of each on sketch.