

Late
A-2004
9-67

MISSISSIPPI
BOARD OF WATER COMMISSIONERS
416 North State Street
Jackson, Mississippi 39201

WATER WELL DRILLERS LOG

1967 date well completed Shaly Newman Late firm name Late county well located

LANDOWNER: Walter Brown
Hernando Miss.
By R. E. Darby
(mailing address)

WELL LOCATION:
sec. 15 T. 4 N S R. 9 E W
4 miles N of Ark
(distance) (direction) (nearest town)

WELL PURPOSE: home
(home, irrigation, municipal, industrial)

WELL COMPLETION DATA:

- (1) diameter (inches) 2
- (2) total depth (feet) 172
- (3) static water level (feet) 88 below above top of ground.
- (4) casing galvanized (material) (depth)
- _____ if telescope see back. (size)
- (5) screen 4 ft (length) (depth to top)
- _____ (size) _____ (material)
- (6) pump 4 (HP) (yield gpm)
Electric (type power)
- (7) electric log yes (yes or no)
no (organization running log)
- (8) how well bottom plugged Rubber Seal


description of formations encountered	from	to
Red clay	0	60
sand to gravel	60	110
grey clay	110	160
white sand	160	172

DRILLERS REMARKS:



If well telescopes please sketch and show depths.

GROUND LEVEL

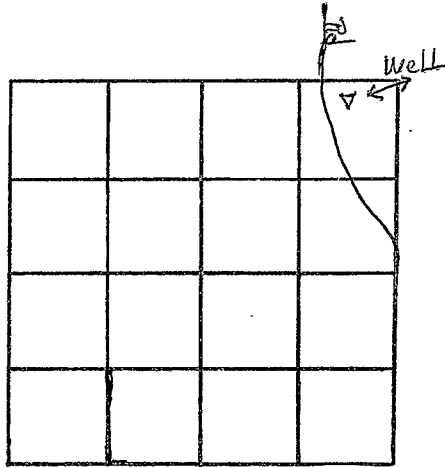

SECTION 15

Please indicate well location X.

ADDITIONAL INFORMATION

If more than one screen, show locations of each on sketch.