

Date  
 A2000  
 11-67

MISSISSIPPI  
 BOARD OF WATER COMMISSIONERS  
 416 North State Street  
 Jackson, Mississippi 39201

WATER WELL DRILLERS LOG

Nov 6, 19 67 Shelby Nemo 7  
 date well completed firm name county well located


LANDOWNER: Sam Toliver  
R. F. D. - 1  
Caldwater Miss  
 (mailing address)

WELL LOCATION:  
 sec. 29 T 4 N R 9 E  
S W  
3 1/2 miles w of Arbuckle  
 (distance) (direction) (nearest town)

WELL PURPOSE: Home  
 (home, irrigation, municipal, industrial)

WELL COMPLETION DATA:  
 (1) diameter (inches) 2  
 (2) total depth (feet) 196  
 (3) static water level (feet) 86 below above  
 top of ground.  
 (4) casing \_\_\_\_\_  
 (material) (depth)  
 \_\_\_\_\_ if telescope see back.  
 (size)  
 (5) screen 6 ft 90 gauge  
 (length) (depth to top)  
1 1/2  
 (size) (material)  
 (6) pump 1/2 4  
 (HP) (yield gpm)  
Electric  
 (type power)  
 (7) electric log no  
 (yes or no)  
no  
 (organization running log)  
 (8) how well bottom plugged Rubber seal

description of formations encountered	from	to
Red clay	0	40
Red sand to gravel	40	95
Blue clay	95	160
blue band	160	180
clean grey sand	180	196

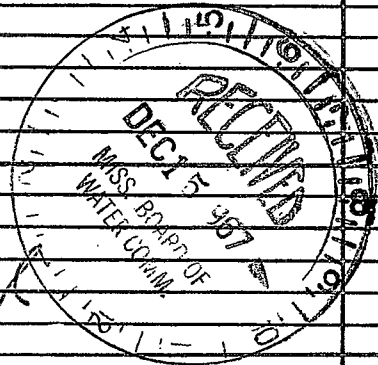

DRILLERS REMARKS:


If well telescopes please  
sketch and show depths.

GROUND LEVEL

Well



X

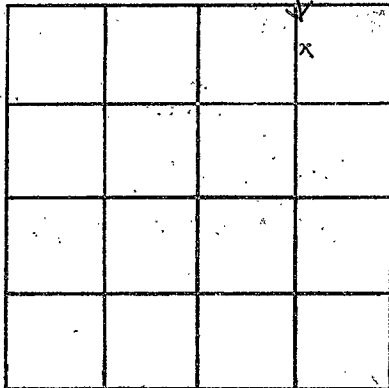

SECTION 29

Please indicate well location X.

**ADDITIONAL INFORMATION**

Lined area for recording additional information.

If more than one screen,  
show locations of each on sketch.