

Late
A 2007
11-67

MISSISSIPPI
BOARD OF WATER COMMISSIONERS
416 North State Street
Jackson, Mississippi 39201

WATER WELL DRILLERS LOG

Nov 9 1967 Shelby Newman Late
date well completed firm name county well located

LANDOWNER: James Turner
Box 7 D. 1
Chalwater Miss
(mailing address)


WELL LOCATION:
sec. 29 T. 4 N. R. 9 E.
3 1/2 miles W of Arbuckle
(distance) (direction) (nearest town)

WELL PURPOSE: Home
(home, irrigation, municipal, industrial)

- WELL COMPLETION DATA:
- (1) diameter (inches) 2
 - (2) total depth (feet) 196
 - (3) static water level (feet) 88 below above top of ground.
 - (4) casing (material) (depth)
_____ if telescope see back.
(size)
 - (5) screen 6 ft 90 gauge
(length) (depth to top)
1 1/4 (size) _____ (material)
 - (6) pump 1 H
(HP) (yield gpm)
Electric (type power)
 - (7) electric log no
(yes or no)
no (organization running log)
 - (8) how well bottom plugged Rubber seal

description of formations encountered	from	to
<u>Red Clay</u>	<u>0</u>	<u>40</u>
<u>Red sand & gravel</u>	<u>40</u>	<u>95</u>
<u>Blue Clay</u>	<u>95</u>	<u>160</u>
<u>Blue Sand</u>	<u>160</u>	<u>185</u>
<u>Clear grey sand</u>	<u>180</u>	<u>196</u>


DRILLERS REMARKS:

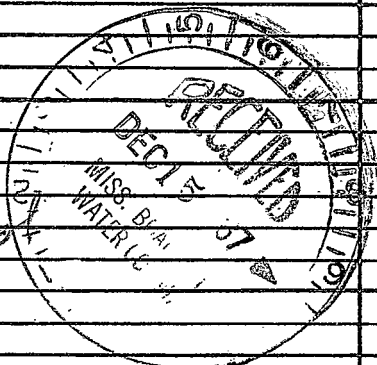

If well telescopes please sketch and show depths.

GROUND LEVEL

Well

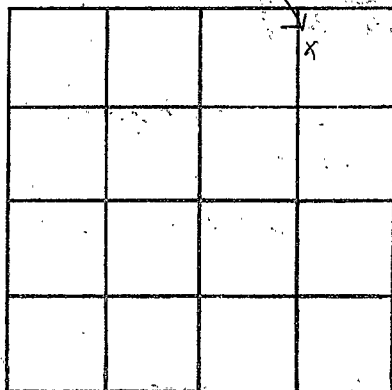

SECTION 27

Please indicate well location X.

ADDITIONAL INFORMATION

If more than one screen, show locations of each on sketch.